


**Attachment 15-1  
2009 Interim Remedial Action Report  
AECOM**

COPYRIGHT © 2014 MASER CONSULTING P.A. - ALL RIGHTS RESERVED.  
 THIS DRAWING AND ALL INFORMATION CONTAINED HEREIN IS UNAUTHORIZED FOR USE OR REPRODUCTION BY ANY PARTY WITHOUT THE WRITTEN CONSENT OF MASER CONSULTING P.A.  
 THE INFORMATION CONTAINED HEREIN IS UNAUTHORIZED FOR USE OR REPRODUCTION BY ANY PARTY WITHOUT THE WRITTEN CONSENT OF MASER CONSULTING P.A.

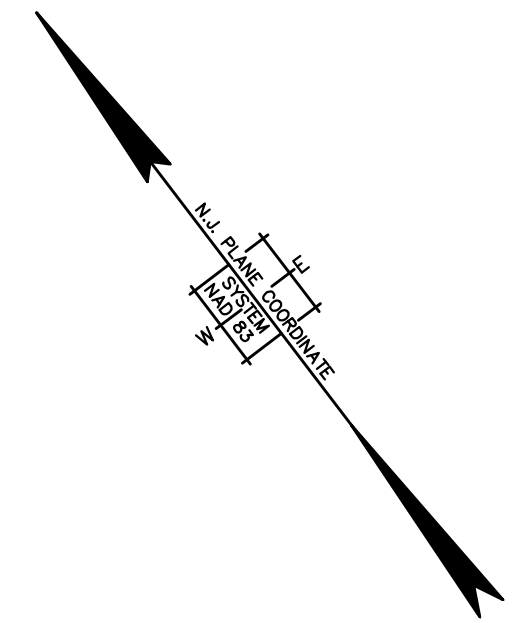

**AECOM EXCAVATION AREA LEGEND**


- EDGE OF PAVEMENT
- MAJOR CONTOUR (0.5')
- EXCAVATION CONTOUR
- TOP OF LINER LOCATION
- CONCRETE
- SOIL BORING LOCATION, ID AND SAM INTERVAL (ELEVATION IN FEET NAVD)
- POST-EXCAVATION SAMPLE LOCATION ID AND ELEVATION IN FEET NAVD 88
- MONITORING WELL
- SPOT ELEVATION
- CONTROL POINT
- 30' SAMPLING GRID AND ID

**GENERAL NOTES**

1. THE SOLE PURPOSE OF THIS PLAN IS TO SHOW POST-EXCAVATION ELEVATIONS WITHIN THE PROPOSED EXCAVATION AREA AT THE PROJECT SITE.
2. POST-EXCAVATION LOCATIONS AND ELEVATIONS WERE OBTAINED BY MASER CONSULTING P.A. ON 6/16/14, 7/3/14, 7/21/14, 7/22/14, 7/24/14, 8/20/14. ADDITIONAL LOCATIONS AND ELEVATIONS WERE OBTAINED BY ENTACT 7/24/14, 7/29/14, 8/5/14, 8/20/14, 9/15/14, 10/26/14, 11/5/14, 2/11/15, 2/20/15, & 6/19/15.
3. HORIZONTAL DATUM NAD 1983, VERTICAL DATUM NAVD88.

**REFERENCES**

1. PLANS ENTITLED, "SOIL REMEDIATION, PPG INDUSTRIES, SITE 016, 45 LINDEN AVENUE EAST, JERSEY CITY, NEW JERSEY, PREPARED FOR PPG INDUSTRIES, INC., JERSEY CITY, NEW JERSEY, DATED 1/20/14, PREPARED BY CB & I.

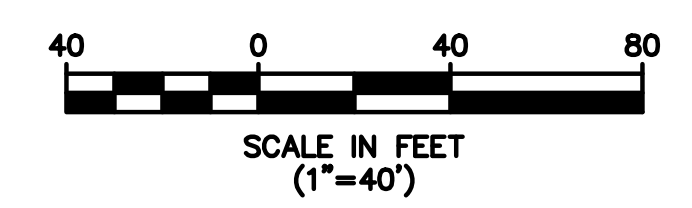

REV.	DATE	DRAWN BY	DESCRIPTION
5.	2/5/19	AY	ADDED AECOM EXCAVATION AREA & SAMPLES WITH SITE GRID
4.	7/21/15	BSB	REVISED TO SHOW POST-EXCAVATION AS OF 6/19/15
3.	3/11/15	BSB	REVISED TO SHOW POST-EXCAVATION AS OF 2/20/15
2.	2/12/15	BSB	REVISED TO SHOW POST-EXCAVATION AS OF 1/28/15
1.	11/26/14	BSB	REVISED TO SHOW POST-EXCAVATION AS OF 11/5/14

**R. THOMAS HUGG**  
 NEW JERSEY PROFESSIONAL  
 LAND SURVEYOR LIC. NO. 36737

**MARMORA OFFICE**  
 156 Stonecoach Road  
 Marmora, N.J. 08223  
 Phone (609) 390-1927  
 Fax (609) 390-0040  
 email: solutions@maserconsulting.com

**POST-EXCAVATION AS-BUILT SURVEY WITH AECOM EXCAVATION AREA FOR ENTACT, LLC SITE 016**  
 45 LINDEN AVENUE EAST  
 LOT 4L, BLOCK 1507  
 JERSEY CITY HUDSON COUNTY NEW JERSEY

JOB NUMBER: 14001020A	DATE: AUGUST 7, 2014
SCALE: 1"=40'	LATEST REVISION: JULY 21, 2015
INDEX NUMBER: MASU001437	DESIGN BY: BSB
SHEET NUMBER: 1	of 1

Regional Offices  
 Red Bank, N.J.  
 Clinton, N.J.  
 Hamilton, N.J.  
 Logan, N.J.  
 Mt. Arlington, N.J.  
 Chestnut Ridge, N.Y.  
 Newburgh, N.Y.  
 Bethlehem, PA.