
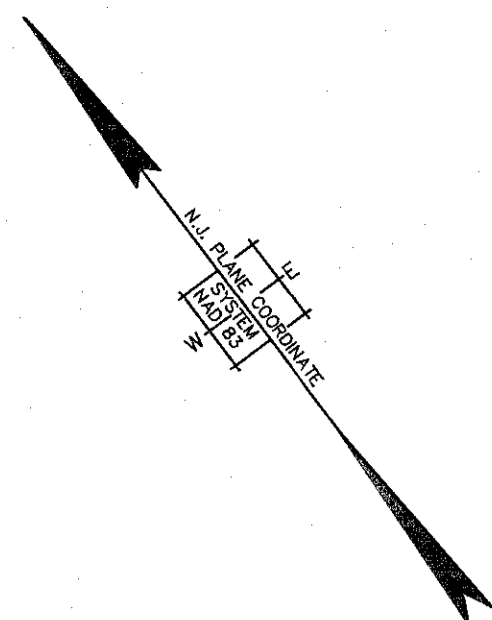


## **Attachment 15**

### **As-Built Drawings**

COPYRIGHT © 2015, MASER CONSULTING P.A. ALL RIGHTS RESERVED.  
 THIS DOCUMENT IS THE PROPERTY OF MASER CONSULTING P.A. AND IS TO BE USED ONLY FOR THE PROJECT AND SITE SPECIFICALLY IDENTIFIED ON THE TITLE SHEET. ANY REUSE OR REPRODUCTION OF THIS DOCUMENT WITHOUT THE WRITTEN PERMISSION OF MASER CONSULTING P.A. IS STRICTLY PROHIBITED.

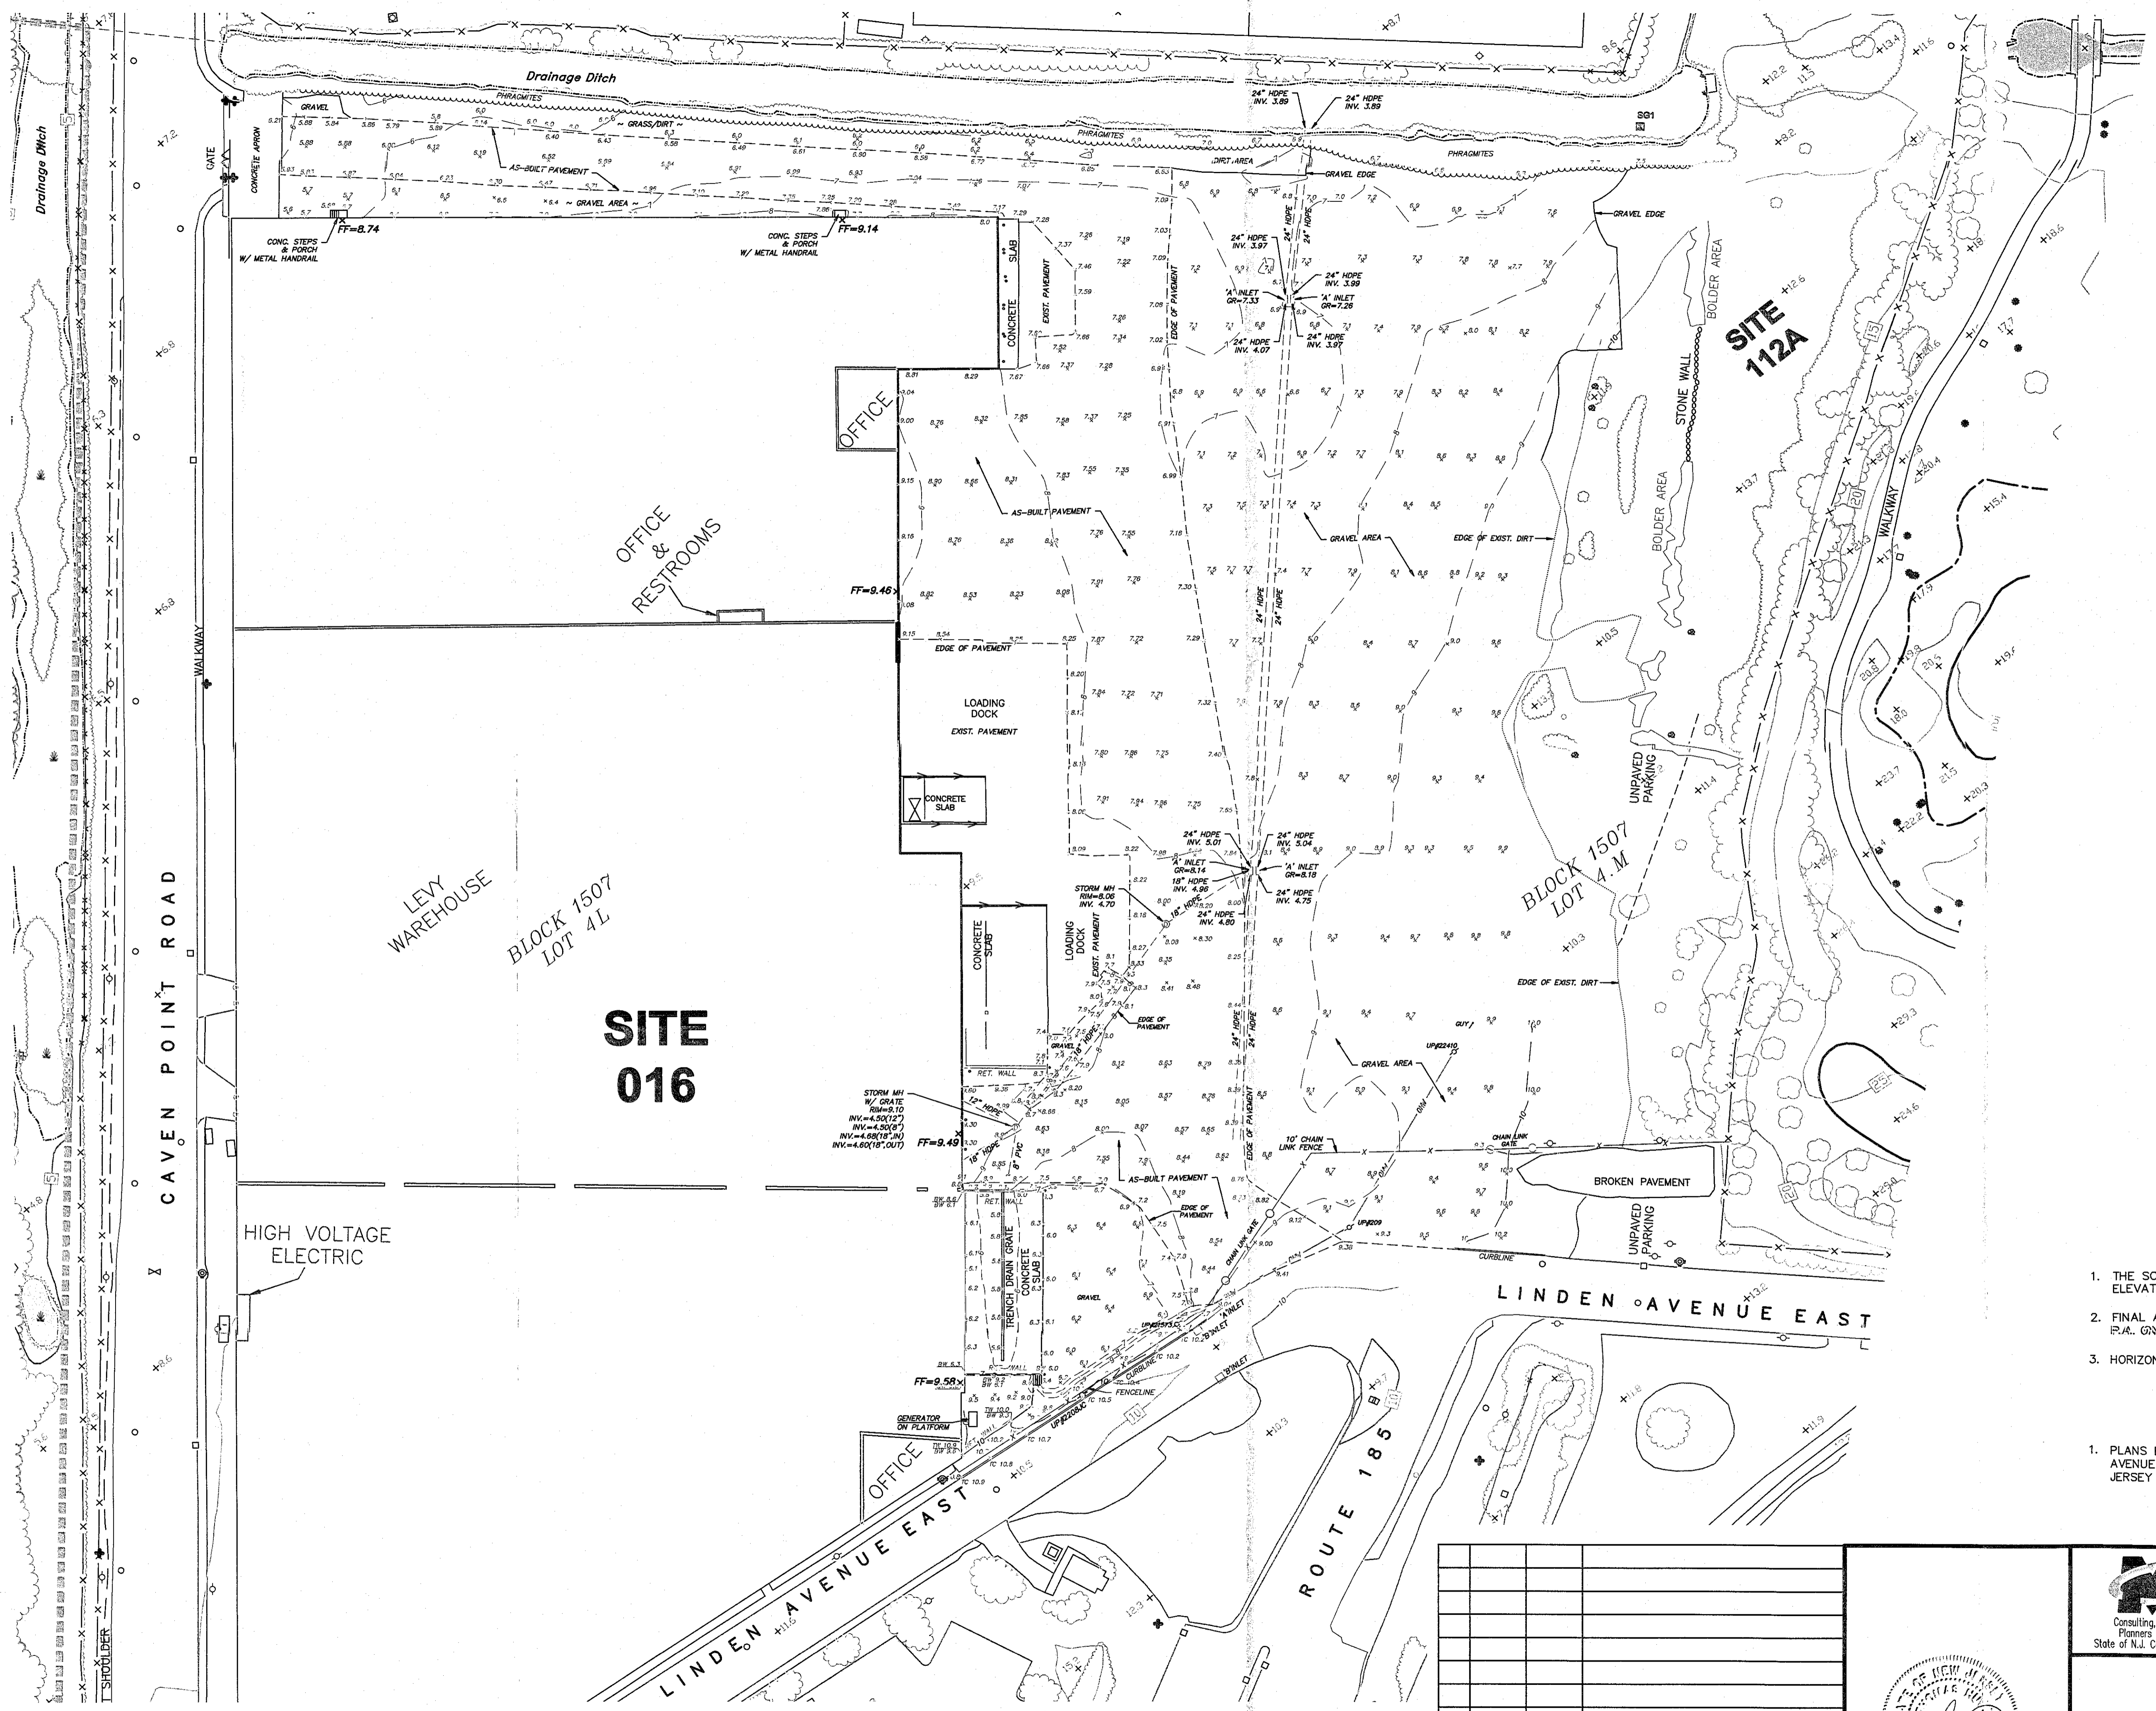

CAVEN POINT ROAD

HIGH VOLTAGE ELECTRIC

LEVY WAREHOUSE

BLOCK 1507 LOT 4L

**SITE 016**

OFFICE

OFFICE & RESTROOMS


OFFICE

BLOCK 1507 LOT 4.M

**SITE 112A**

LINDEN AVENUE EAST

ROUTE 185 BY

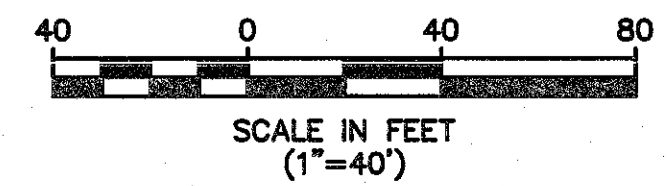

**GENERAL NOTES**

1. THE SOLE PURPOSE OF THIS PLAN IS TO SHOW FINAL AS-BUILT LOCATIONS & ELEVATIONS AT THE PROJECT SITE.
2. FINAL AS-BUILT LOCATIONS AND ELEVATIONS WERE OBTAINED BY MASER CONSULTING P.A. ON 3/22/15 & 7/23/15.
3. HORIZONTAL DATUM NAD 1983, VERTICAL DATUM NAVD88.

**REFERENCES**

1. PLANS ENTITLED, "SOIL REMEDIATION, PPG INDUSTRIES, SITE 016, 45 LINDEN AVENUE EAST, JERSEY CITY, NEW JERSEY, PREPARED FOR PPG INDUSTRIES, INC., JERSEY CITY, NEW JERSEY, DATED 1/20/14, PREPARED BY CB & I.

REV.	DATE	DRAWN BY	DESCRIPTION
1.	8/11/15	BSB	REVISED TO SHOW FINAL AS-BUILT CONDITIONS AS OF 7/23/15

**R. THOMAS HUGG**  
 NEW JERSEY PROFESSIONAL LAND SURVEYOR LIC. NO. 36737

**MASER CONSULTING P.A.**  
 Consulting, Municipal & Environmental Engineers  
 Planners • Surveyors • Landscape Architects  
 State of N.J. Certificate of Authorization: 246427986500  
 email: solutions@maserconsulting.com

**WARMORA OFFICE**  
 150 Stegmann Road  
 Warmora, N.J. 08223  
 Phone (609) 390-1927  
 Fax (609) 390-0040

Regional Offices:  
 Red Bank, N.J.  
 Clinton, N.J.  
 Hamilton, N.J.  
 Logan, N.J.  
 Mt. Arlington, N.J.  
 Chester Ridge, N.Y.  
 Newburgh, N.Y.  
 Bethlehem, PA.

**FINAL AS-BUILT SURVEY**

FOR


**ENTACT, LLC**

**SOIL REMEDIATION PPG INDUSTRIES**

**SITE 016**

45 LINDEN AVENUE EAST  
 LOT 4L, BLOCK 1507  
 JERSEY CITY HUDSON COUNTY NEW JERSEY

JOB NUMBER: 14001020A	DATE: APRIL 3, 2015
SCALE: 1"=40'	LATEST REVISION: AUGUST 11, 2015
INDEX NUMBER: MASU001579	DESIGN BY: BSB
SHEET NUMBER: 1	of 1

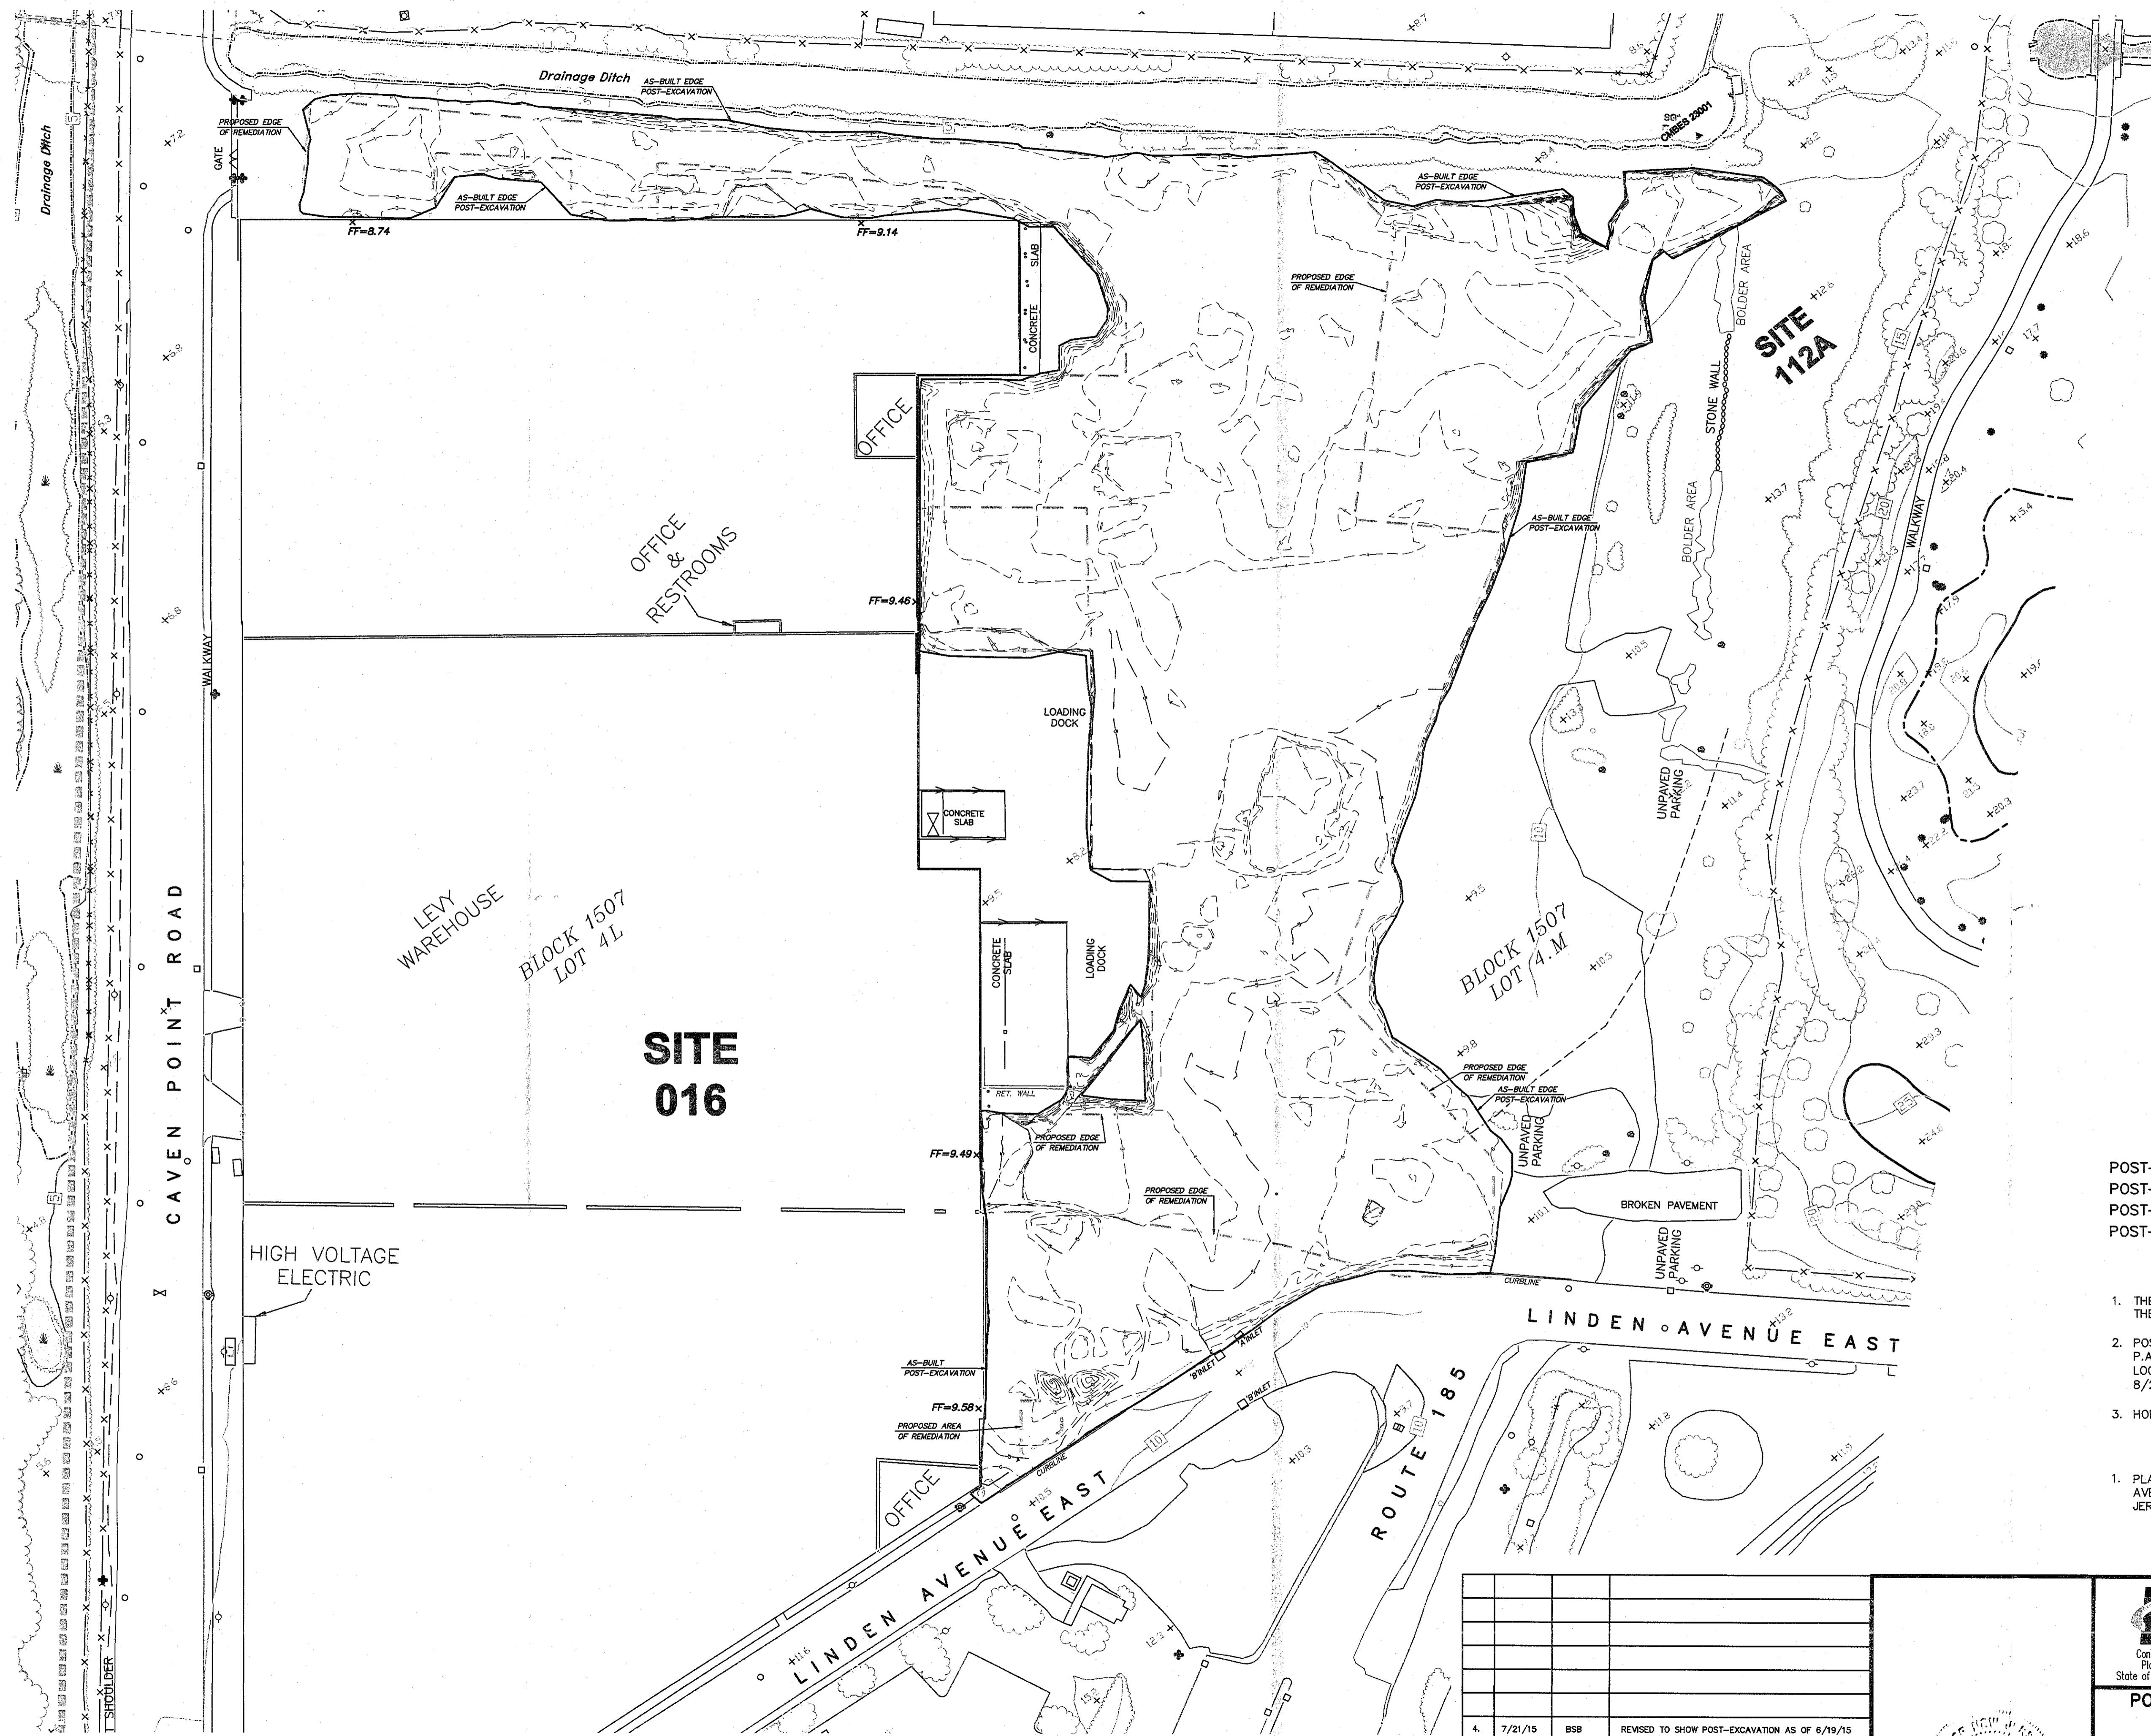

**VOLUME QUANTITIES**


POST-EXCAVATION TOTAL VOLUME AS OF 7/29/14 = 8,650 CU.YDS. ±  
 POST-EXCAVATION TOTAL VOLUME AS OF 11/5/14 = 19,297 CU.YDS. ±  
 POST-EXCAVATION TOTAL VOLUME AS OF 2/20/15 = 22,610 CU.YDS. ±  
 POST-EXCAVATION TOTAL VOLUME AS OF 6/19/15 = 23,835 CU.YDS. ±

**GENERAL NOTES**

1. THE SOLE PURPOSE OF THIS PLAN IS TO SHOW POST-EXCAVATION ELEVATIONS WITHIN THE PROPOSED EXCAVATION AREA AT THE PROJECT SITE.
2. POST-EXCAVATION LOCATIONS AND ELEVATIONS WERE OBTAINED BY MASER CONSULTING P.A. ON 6/16/14, 7/3/14, 7/21/14, 7/22/14, 7/24/14, 8/20/14. ADDITIONAL LOCATIONS AND ELEVATIONS WERE OBTAINED BY ENTACT 7/24/14, 7/29/14, 8/5/14, 8/20/14, 9/15/14, 10/26/14, 11/5/14, 2/11/15, 2/20/15, & 6/19/15.
3. HORIZONTAL DATUM NAD 1983, VERTICAL DATUM NAVD88.

**REFERENCES**

1. PLANS ENTITLED, "SOIL REMEDIATION, PPG INDUSTRIES, SITE 016, 45 LINDEN AVENUE EAST, JERSEY CITY, NEW JERSEY, PREPARED FOR PPG INDUSTRIES, INC., JERSEY CITY, NEW JERSEY, DATED 1/20/14, PREPARED BY CB & I.

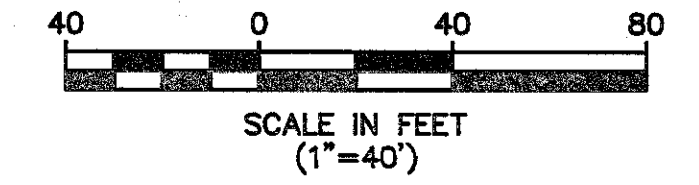

REV.	DATE	DRAWN BY	DESCRIPTION
4.	7/21/15	BSB	REVISED TO SHOW POST-EXCAVATION AS OF 6/19/15
3.	3/11/15	BSB	REVISED TO SHOW POST-EXCAVATION AS OF 2/20/15
2.	2/12/15	BSB	REVISED TO SHOW POST-EXCAVATION AS OF 1/28/15
1.	11/26/14	BSB	REVISED TO SHOW POST-EXCAVATION AS OF 11/5/14

**R. THOMAS HOGG**  
 NEW JERSEY PROFESSIONAL  
 LAND SURVEYOR LIC. NO. 36737

**MASER CONSULTING P.A.**  
 Consulting, Municipal & Environmental Engineers  
 Planners • Surveyors • Landscape Architects  
 MARMORA OFFICE  
 156 Steeplechase Road  
 Marmora, N.J. 08223  
 Phone (609) 390-1927  
 Fax (609) 390-0040  
 email: solutions@maserconsulting.com

Regional Offices:  
 Red Bank, N.J.  
 Clinton, N.J.  
 Hamilton, N.J.  
 Logan, N.J.  
 Mt. Arlington, N.J.  
 Chestnut Ridge, N.Y.  
 Newburgh, N.Y.  
 Bethlehem, PA.

**POST-EXCAVATION AS-BUILT SURVEY**  
 FOR  
**ENTACT, LLC**  
 SOIL REMEDIATION PPG INDUSTRIES  
 SITE 016  
 45 LINDEN AVENUE EAST  
 LOT 4L, BLOCK 1507  
 JERSEY CITY HUDSON COUNTY NEW JERSEY

JOB NUMBER: 14001020A	DATE: AUGUST 7, 2014
SCALE: 1"=40'	LATEST REVISION: JULY 21, 2015
INDEX NUMBER: MASU001437	DESIGN BY: BSB
SHEET NUMBER: 1	of 1

COPYRIGHT © 2014 MASER CONSULTING P.A. ALL RIGHTS RESERVED.  
 NO PART OF THIS DOCUMENT IS TO BE REPRODUCED OR TRANSMITTED IN ANY FORM OR BY ANY MEANS, ELECTRONIC OR MECHANICAL, INCLUDING PHOTOCOPYING, RECORDING, OR BY ANY INFORMATION STORAGE AND RETRIEVAL SYSTEM, WITHOUT PERMISSION IN WRITING FROM MASER CONSULTING P.A.