

LEGEND

	PROPERTY LINE
	EDGE OF CONCRETE
	EXISTING BUILDING
	BUILDING DOOR
	NEW JERSEY TRANSIT - LIGHT RAIL
	RESTORATION AS-BUILT ELEVATION CONTOURS
	EXISTING SHEET PILE
	SEWER UTILITY LINE
	COMBINED SEWER MANHOLE
	CATCH BASIN INLET
	HDPE LINER
	GCCM
	ASPHALT
	STONE SURFACE FINISH
	CONCRETE SIDEWALK
	PAVED SIDEWALK

NOTES:

- ELEVATIONS ARE SHOWN IN FT NAVD88.
- PROPERTY BOUNDARIES ARE SOURCED FROM THE "BOUNDARY AND TOPOGRAPHIC SURVEY, PPG INDUSTRIES, SITE 114, LOTS 11, 12, 14 AND 15, BLOCK 21501, CITY OF JERSEY CITY, HUDSON COUNTY, NEW JERSEY" PREPARED BY BORBAS SURVEYING AND MAPPING, LLC, DATED JANUARY 8, 2019.
- RESTORATION AS-BUILT ELEVATION CONTOURS ARE SOURCED FROM THE "FINAL AS-BUILT SURVEY FOR ENACT, LLC, PPG SITE 113 & 135, SKYWAYS, 300 GARFIELD AVENUE, JERSEY CITY, HUDSON COUNTY, NEW JERSEY" PREPARED BY MASER CONSULTING P.A., DATED SEPTEMBER 25, 2018.

FT FEET OR FOOT
GCCM GEOSYNTHETIC CEMENTITIOUS COMPOSITE MAT
HDPE HIGH-DENSITY POLYETHYLENE
NAVD88 NORTH AMERICAN VERTICAL DATUM OF 1988

File: K:\7-deliverables\7.19-closure\Forrest\19-closure\Forrest\19-02-08 Final BMAP\1.0 Figures\CO\2019-02-19 Figure 6-1.dwg Layout: Figure 7-1 User: ambarish Photo: Mar 19, 2019 - 10:57am Proj: S:

BLOCK 21501/LOT 16



BLOCK 21501/LOT 15

BLOCK 21501/LOT 14

BLOCK 21501/LOTS 11 & 12

FORREST STREET

NEW JERSEY TRANSIT - LIGHT RAIL

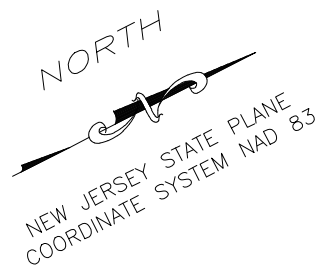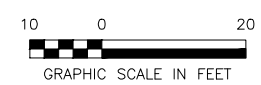

PPG FORREST CURRENT-USE REMEDIATION AREAS JERSEY CITY, NEW JERSEY	
DATE: 03/19/2019	DRWN: SAP

REMEDIAL ACTION WORK PLAN RESTORATION AS-BUILT
FIGURE 6-1