

File: K:\7-Deliverables\7.19-00Group\0406\Forrest Street Properties\709-0288\FSP-Full\RAI\2019-01-15 DRAFT\Appendix C - Draft Sheet Notice\Exhibit B (CAD)\2019-01-04_FSP Restoration_Events.dwg Layout: Figure 7-1 User: Amy.Kroyer Plotfile: Feb 13, 2019 - 3:43pm Xref's:




| LEGEND | |
|--------|---|
| | PROPERTY LINE |
| | EDGE OF CONCRETE |
| | EXISTING BUILDING |
| | BUILDING DOOR |
| | NEW JERSEY TRANSIT - LIGHT RAIL |
| | RESTORATION AS-BUILT ELEVATION CONTOURS |
| | EXISTING SHEET PILE |
| | SEWER UTILITY LINE |
| | COMBINED SEWER MANHOLE |
| | CATCH BASIN INLET |
| | HDPE LINER |
| | GCCM |
| | ASPHALT |
| | STONE SURFACE FINISH |
| | CONCRETE SIDEWALK |
| | PAVED SIDEWALK |

NOTES:
 1. ELEVATIONS ARE SHOWN IN FT NAVD88.
 2. PROPERTY BOUNDARIES ARE SOURCED FROM THE "BOUNDARY AND TOPOGRAPHIC SURVEY, PPG INDUSTRIES, SITE 114, LOTS 11, 12, 14 AND 15, BLOCK 21501, CITY OF JERSEY CITY, HUDSON COUNTY, NEW JERSEY" PREPARED BY BORBAS SURVEYING AND MAPPING, LLC, DATED JANUARY 8, 2019.
 3. RESTORATION AS-BUILT ELEVATION CONTOURS ARE SOURCED FROM THE "FINAL AS-BUILT SURVEY FOR ENACT, LLC; PPG SITE 113 & 135, SQUIWAYS, 900 GARFIELD AVENUE, JERSEY CITY, HUDSON COUNTY, NEW JERSEY" PREPARED BY MASER CONSULTING P.A., DATED SEPTEMBER 25, 2018.

FT FEET OR FOOT
 GCCM GEOSYNTHETIC CEMENTITIOUS COMPOSITE MAT
 HDPE HIGH-DENSITY POLYETHYLENE
 NAVD88 NORTH AMERICAN VERTICAL DATUM OF 1988
 PI PROGRAM INTEREST

| | | | | | | | |
|----|------|----------|---------------------|------|------|-------|------|
| 7 | | | | | | | |
| 6 | | | | | | | |
| 5 | | | | | | | |
| 4 | | | | | | | |
| 3 | | | | | | | |
| 2 | | | | | | | |
| 1 | | | | | | | |
| 0 | ASK | 01/04/19 | RESTORATION EXTENTS | | | | |
| NO | DRWN | DATE | REVISION | CHKD | DATE | APPVD | DATE |

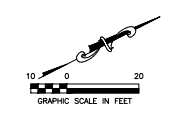

AECOM
www.aecom.com

PPG
 GARFIELD AVENUE SITES
 JERSEY CITY, HUDSON COUNTY, NEW JERSEY

PROJ. NUMBER: 60545281
 DATE: 01/07/2019

**FORREST STREET AND
 FORREST STREET PROPERTIES
 RESTORATION AS-BUILT**

BLOCK 21501, LOT 15 AND FORREST STREET
 PI NUMBER 775706

| |
|----------------------------|
| DRAWING NUMBER: FIG 7-1 |
| SHEET NUMBER: 1 of 1 |
| REVISION 0 |