


## **Appendix F**

### **As-Built Diagrams**



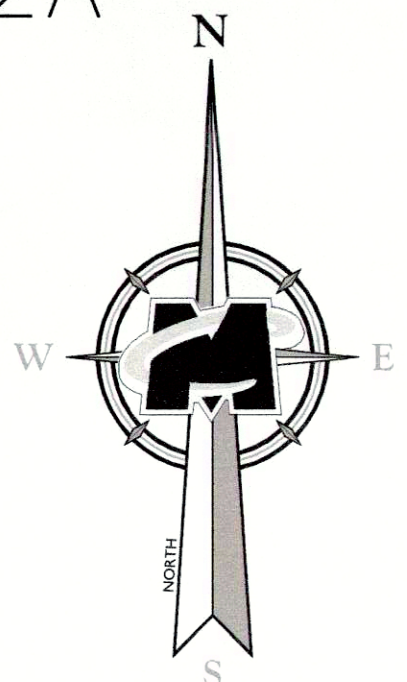

AOC HSS-1A & AOC HSS-2A

AOC 133E-1A & AOC 133E-2A

AOC 135-1

LIMITS OF POST EXCAVATION  
DATA


AOC ASM-1

NOTES:

1. THE SOLE PURPOSE OF THIS PLAN IS TO SHOW THE POST-EXCAVATION LOCATIONS AND ELEVATIONS IN THE HSS 133E 135 ASM EXCAVATION OF THE PROJECT SITE 133/135. POST- EXCAVATION LOCATIONS AND ELEVATIONS WERE OBTAINED BY ENTACT BETWEEN FEBRUARY 2016 THROUGH THRU JANUARY, 2018.
2. HORIZONTAL DATUM NAD83 ; VERTICAL DATUM NAVD88

LEGEND

- = POST EXCAVATION ELEVATIONS
- ~ = SHEET PILING
- = MAJOR CONTOUR
- - - - = MINOR CONTOUR
- = AREA OF CONCERN (AOC)

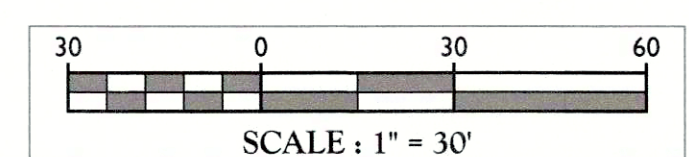

**R. THOMAS HUGG**  
NEW JERSEY PROFESSIONAL  
LAND SURVEYOR - LICENSE NUMBER: GS36737

POST EXCAVATION  
ELEVATION PLAN  
FOR  
ENTACT, LLC

PPG SITE 133/135  
HSS 133E 135 ASM  
EXCAVATION  
900 GARFIELD AVENUE  
JERSEY CITY  
HUDSON COUNTY, NJ


EGG HARBOR OFFICE  
300 Scarborough Drive,  
Suite 108  
Egg Harbor, NJ 08234  
Phone: 609.390.1927  
Fax: 609.390.0040


SCALE: AS SHOWN DATE: 05-09-18 DRAWN BY: DMS CHECKED BY: RTH  
PROJECT NUMBER: 1200089A CONTACT: 1200089A SURVEY: 133E 135 ASM

SHEET TITLE:  
POST EXCAVATION  
ELEVATION PLAN

SHEET NUMBER:  
01 of 01



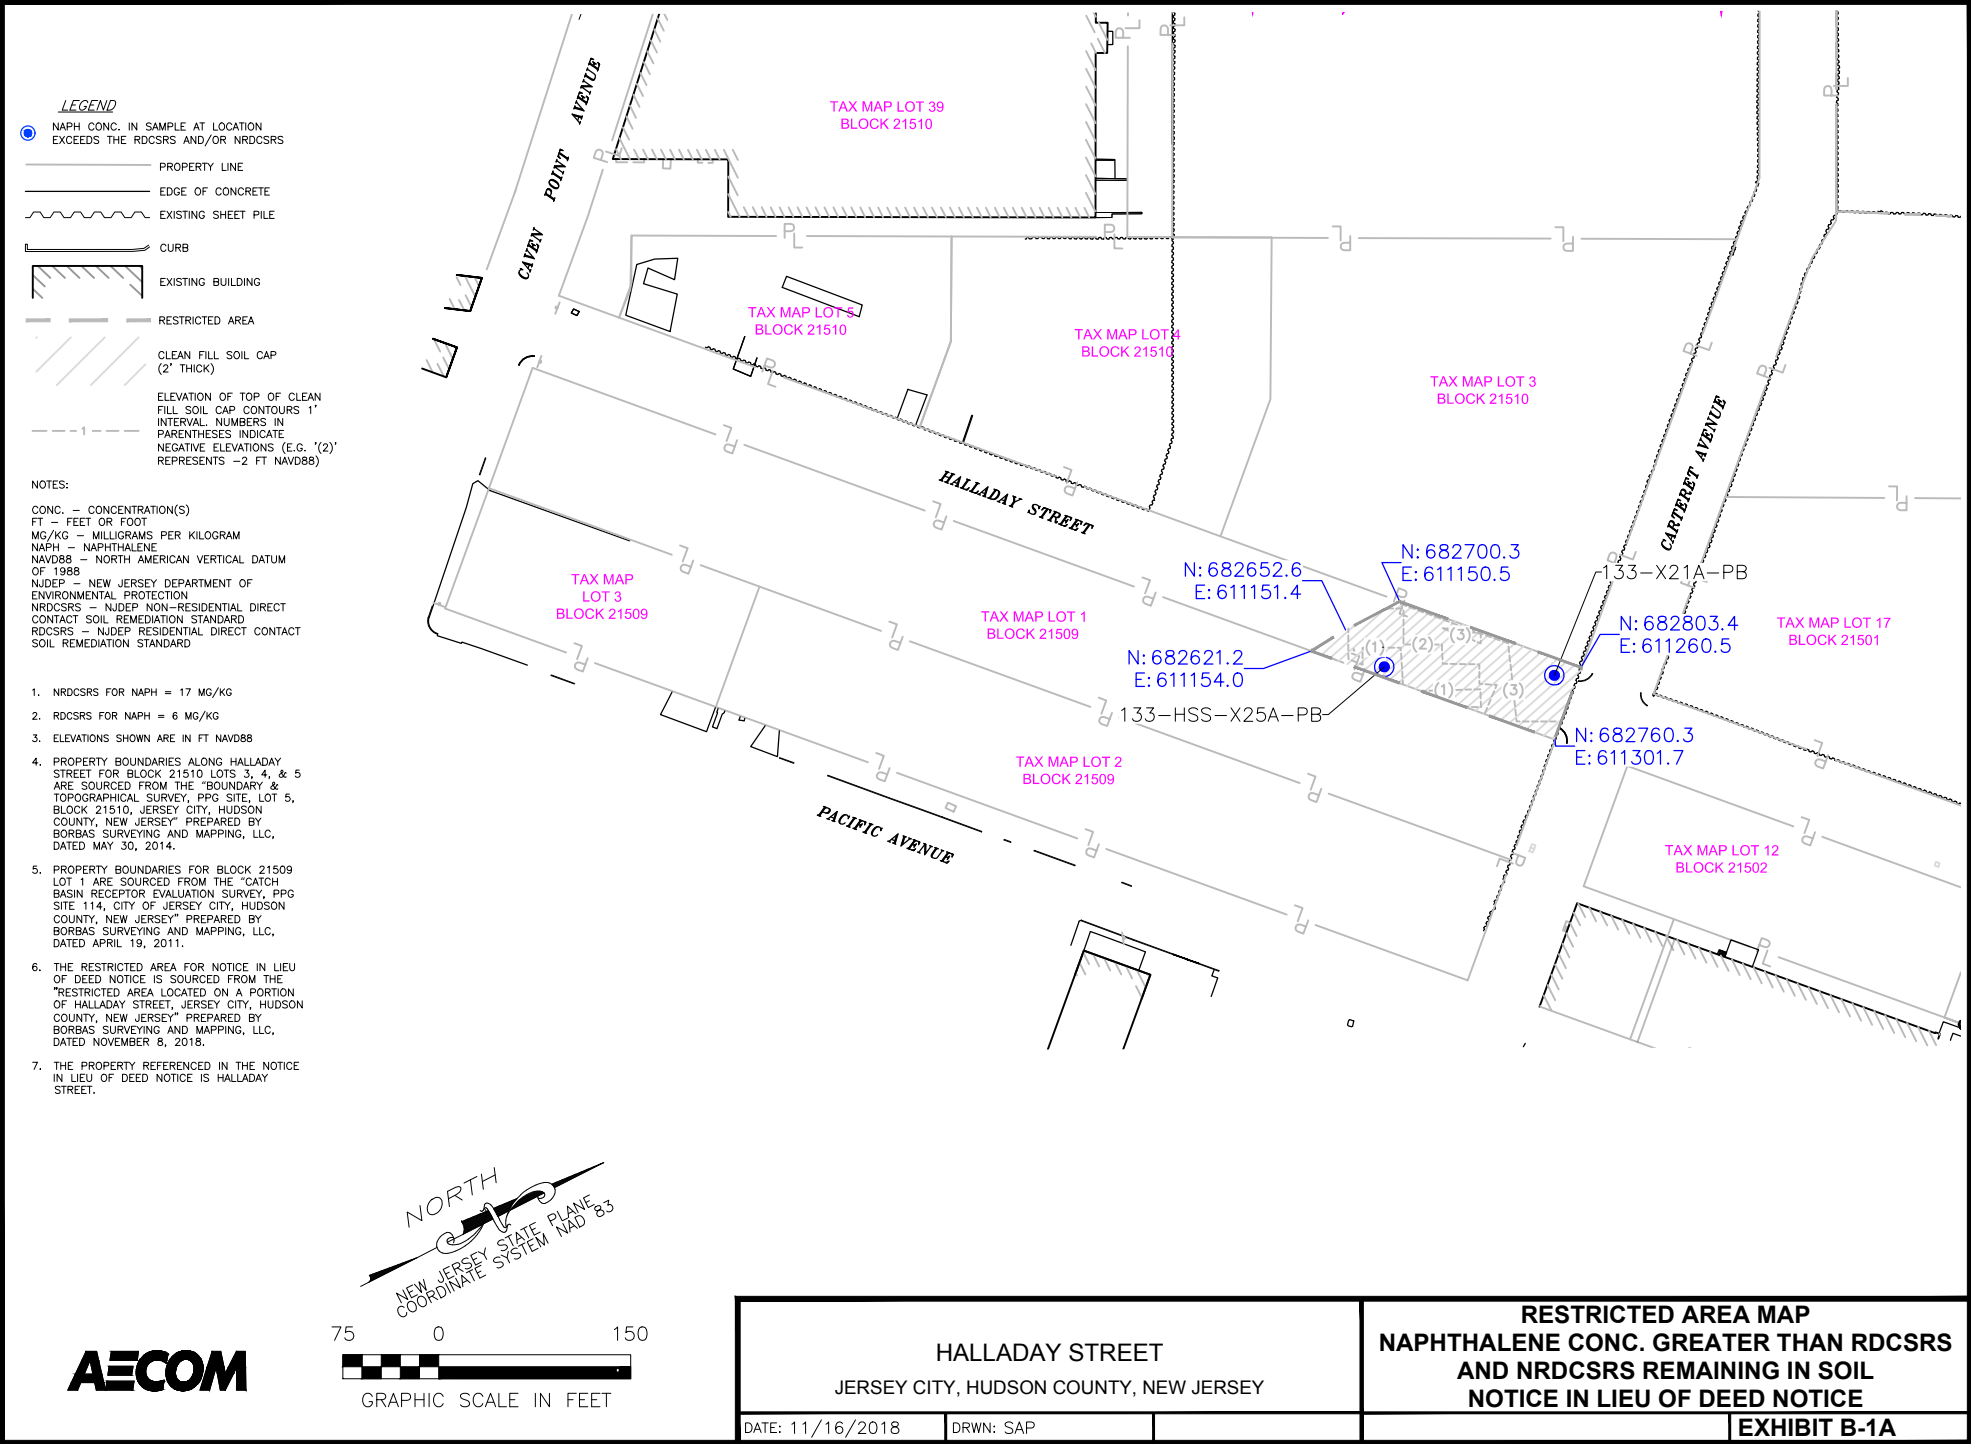

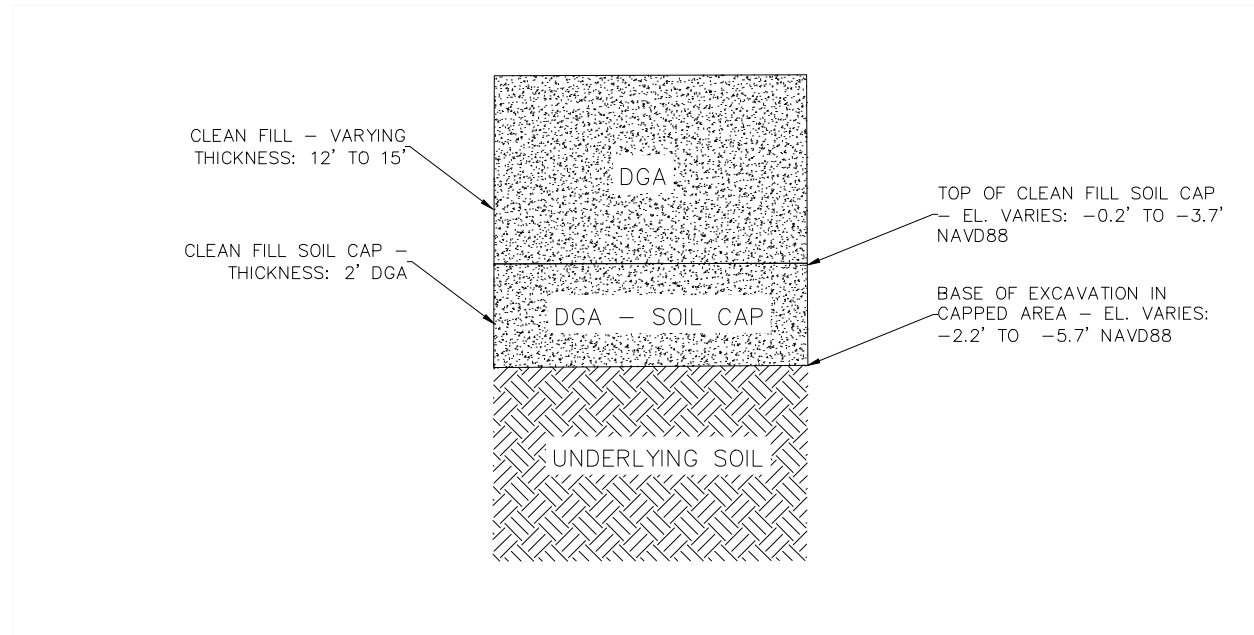

NOTES:

1) DGA MAY BE AMENDED WITH FERROBLACK®-H, WHICH SERVES AS A PHASE OF GROUNDWATER REMEDIATION.

DGA - DENSE-GRADED AGGREGATE  
EL. - ELEVATION

NAVD88 - NORTH AMERICAN VERTICAL DATUM OF 1988

NTS - NOT TO SCALE

1 CLEAN FILL SOIL CAP  
NTS

**AECOM**


PPG  
HALLADAY STREET  
JERSEY CITY, HUDSON COUNTY, NEW JERSEY

**ENGINEERING CONTROL  
AS-BUILT TYPICAL SECTION**

DATE: 05/31/2018

DRWN: SAP



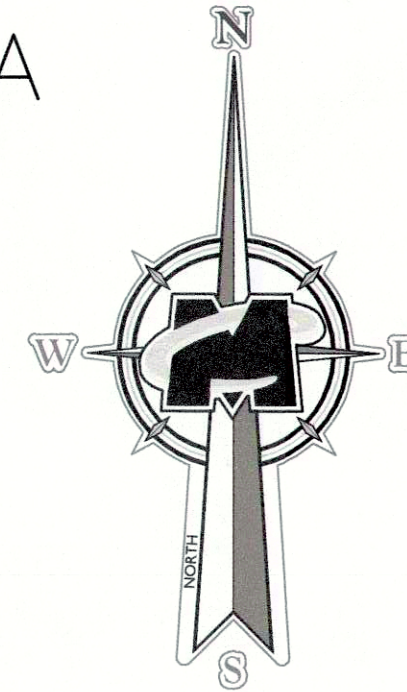

AOC 135-1

AOC HSS-1A & AOC HSS-2A

AOC ASM-1.

## LIMITS OF FINAL RESTORATION GRADING DATA

1. THE SOLE PURPOSE OF THIS PLAN IS TO SHOW THE FINAL RESTORATION GRADING IN THE HSS 133E 135 ASM EXCAVATION OF THE PROJECT SITE 133/135. FINAL GRADING AND RESTORATION LOCATIONS AND ELEVATIONS WERE OBTAINED BY ENTACT BETWEEN JANUARY THRU MAY, 2018.
2. HORIZONTAL DATUM NAD83 ; VERTICAL DATUM NAVD88




**811**  
Know what's below.  
Call before you dig.

**PROTECT YOURSELF**  
ALL STATES REQUIRE NOTIFICATION OF  
EXCAVATORS, DESIGNERS, OR ANY PERSON  
PREPARING TO DISTURB THE EARTH'S  
SURFACE ANYWHERE IN ANY STATE

FOR STATE SPECIFIC DIRECT PHONE NUMBERS VISIT:  
[WWW.CALL811.COM](http://WWW.CALL811.COM)


REV	DATE	DRAWN BY	DESCRIPTION
1	1	1	1
2	2	2	2
3	3	3	3
100	100	100	100

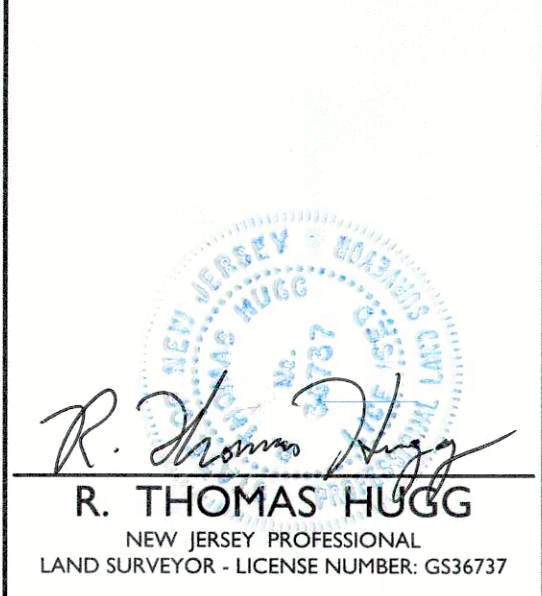[illegible]

FINAL RESTORATION  
GRADE PLAN

FOR  
ENTACT, LLC

PPG SITE 133/135  
HSS133E 135 ASM  
EXCAVATION  
  
900 GARFIELD AVENUE  
JERSEY CITY  
HUDSON COUNTY, NJ

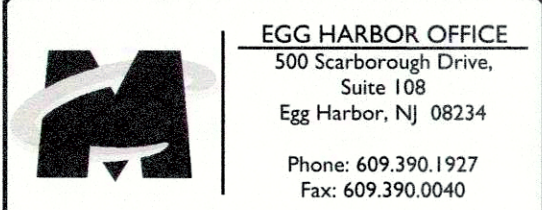

SCALE: AS SHOWN	DATE: 05-09-18	DRAWN BY: DMS	CHECKED BY: RTH
PROJECT NUMBER: 12000589A		RECORD NO. 133502 INTACT SURVEY HSS 133E 135 CHAINAGE 133502	

## FINAL RESTORATION GRADE PLAN

01 of 01