
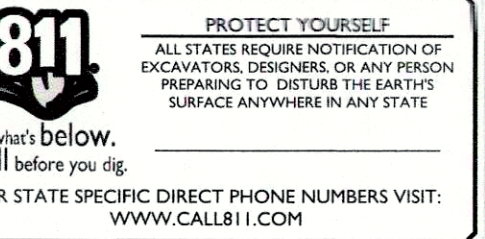


## **Appendix L**

### **As-Built Diagrams**

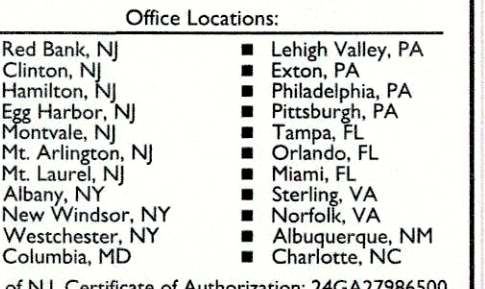

[illegible][illegible]

# POST EXCAVATION ELEVATION PLAN

FOR  
ENTACT, LLC

PPG SITE 137  
EXCAVATION

GARFIELD AVENUE  
JERSEY CITY  
HUDSON COUNTY, NJ



DATE:	DRAWN BY:	CHECKED BY:
05-25-18	DMS	RTH
PROJECT NUMBER:	REVISED TO: 10-04-20	
20050589A	ENACT SURVEY SITE	

### POST EXCAVATION ELEVATION PLAN

01 of 01



NOTES:



1. THE SOLE PURPOSE OF THIS PLAN IS TO SHOW THE POST-EXCAVATION LOCATIONS AND ELEVATIONS IN SITE 137 EXCAVATION. POST- EXCAVATION LOCATIONS AND ELEVATIONS WERE OBTAINED BY ENTACT BETWEEN FEBRUARY 2016 THROUGH THRU JANUARY, 2018
2. HORIZONTAL DATUM NAD83 ; VERTICAL DATUM NAVD88

### LEGEND




○ = POST EXCAVATION ELEVATIONS

 = SHEET PILING

———— = AREA OF CONCERN (AOC)

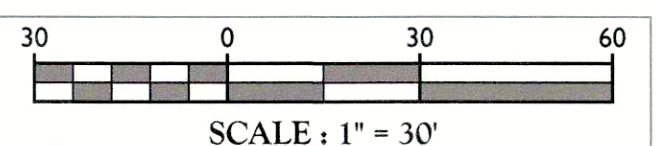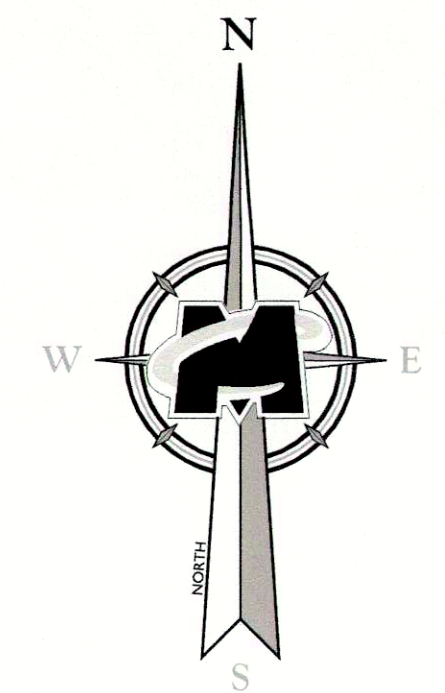



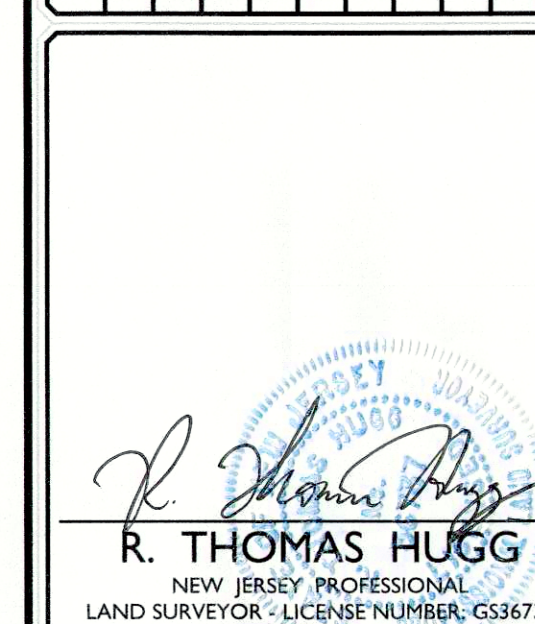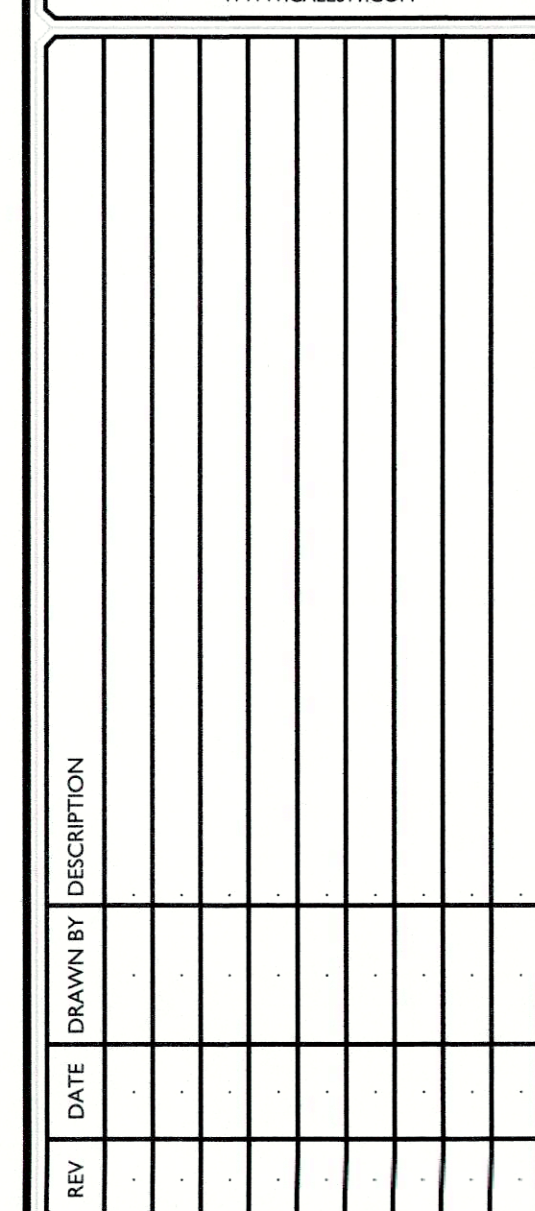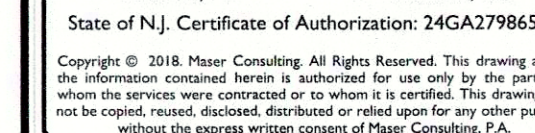

POST EXCAVATION  
ELEVATION PLAN

FOR

ENTACT, LLC


PPG SITE 143  
EXCAVATION  
900 GARFIELD AVENUE  
JERSEY CITY  
HUDSON COUNTY, NJ



SCALE: AS SHOWN	DATE: 05-25-18	DRAWN BY: DMS	CHECKED BY: RTH
PROJECT NUMBER: 12005680A		REVISION: 2018-04-30 CONTACT	

12/06/2017  
SURVEY SITE  
143.MODEL.MODEL.SAVEDOWN  
SHEET TITLE:  
POST EXCAVATION  
ELEVATION PLAN

SHEET NUMBER: 01 of 01

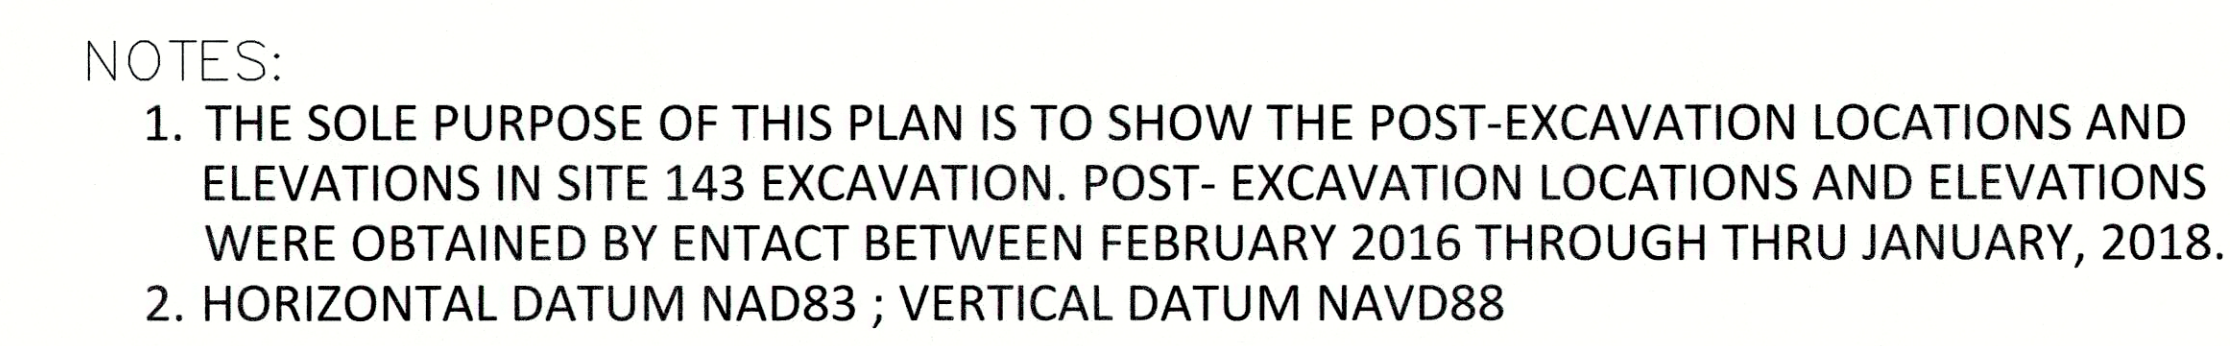

-



