


Appendix K

As-Built Diagrams

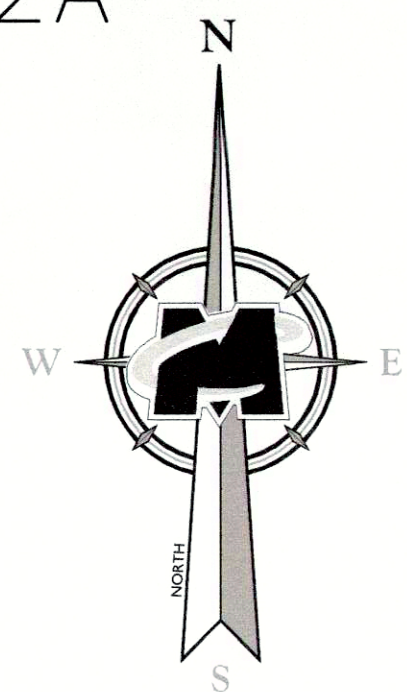

AOC HSS-1A & AOC HSS-2A

AOC 133E-1A & AOC 133E-2A

AOC 135-1

LIMITS OF POST EXCAVATION
DATA


AOC ASM-1

NOTES:

1. THE SOLE PURPOSE OF THIS PLAN IS TO SHOW THE POST-EXCAVATION LOCATIONS AND ELEVATIONS IN THE HSS 133E 135 ASM EXCAVATION OF THE PROJECT SITE 133/135. POST- EXCAVATION LOCATIONS AND ELEVATIONS WERE OBTAINED BY ENTACT BETWEEN FEBRUARY 2016 THROUGH THRU JANUARY, 2018.
2. HORIZONTAL DATUM NAD83 ; VERTICAL DATUM NAVD88

LEGEND

- = POST EXCAVATION ELEVATIONS
- ~ = SHEET PILING
- = MAJOR CONTOUR
- - - - = MINOR CONTOUR
- = AREA OF CONCERN (AOC)

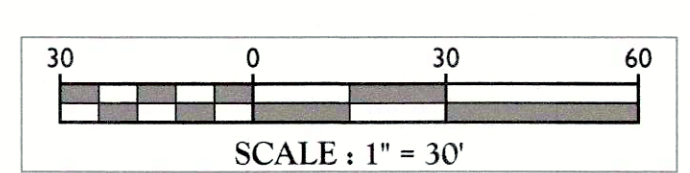

R. Thomas Hugg
R. THOMAS HUGG
NEW JERSEY PROFESSIONAL
LAND SURVEYOR - LICENSE NUMBER: G536737


POST EXCAVATION
ELEVATION PLAN
FOR
ENTACT, LLC

PPG SITE 133/135
HSS 133E 135 ASM
EXCAVATION
900 GARFIELD AVENUE
JERSEY CITY
HUDSON COUNTY, NJ

EGG HARBOR OFFICE
300 Scarborough Drive,
Suite 108
Egg Harbor, NJ 08234
Phone: 609.390.1927
Fax: 609.390.0040

SCALE:	DATE:	DRAWN BY:	CHECKED BY:
AS SHOWN	05-09-18	DHS	RTM
PROJECT NUMBER:	CONTACT:		
1200089A	1200089A		

SHEET TITLE:
**POST EXCAVATION
ELEVATION PLAN**

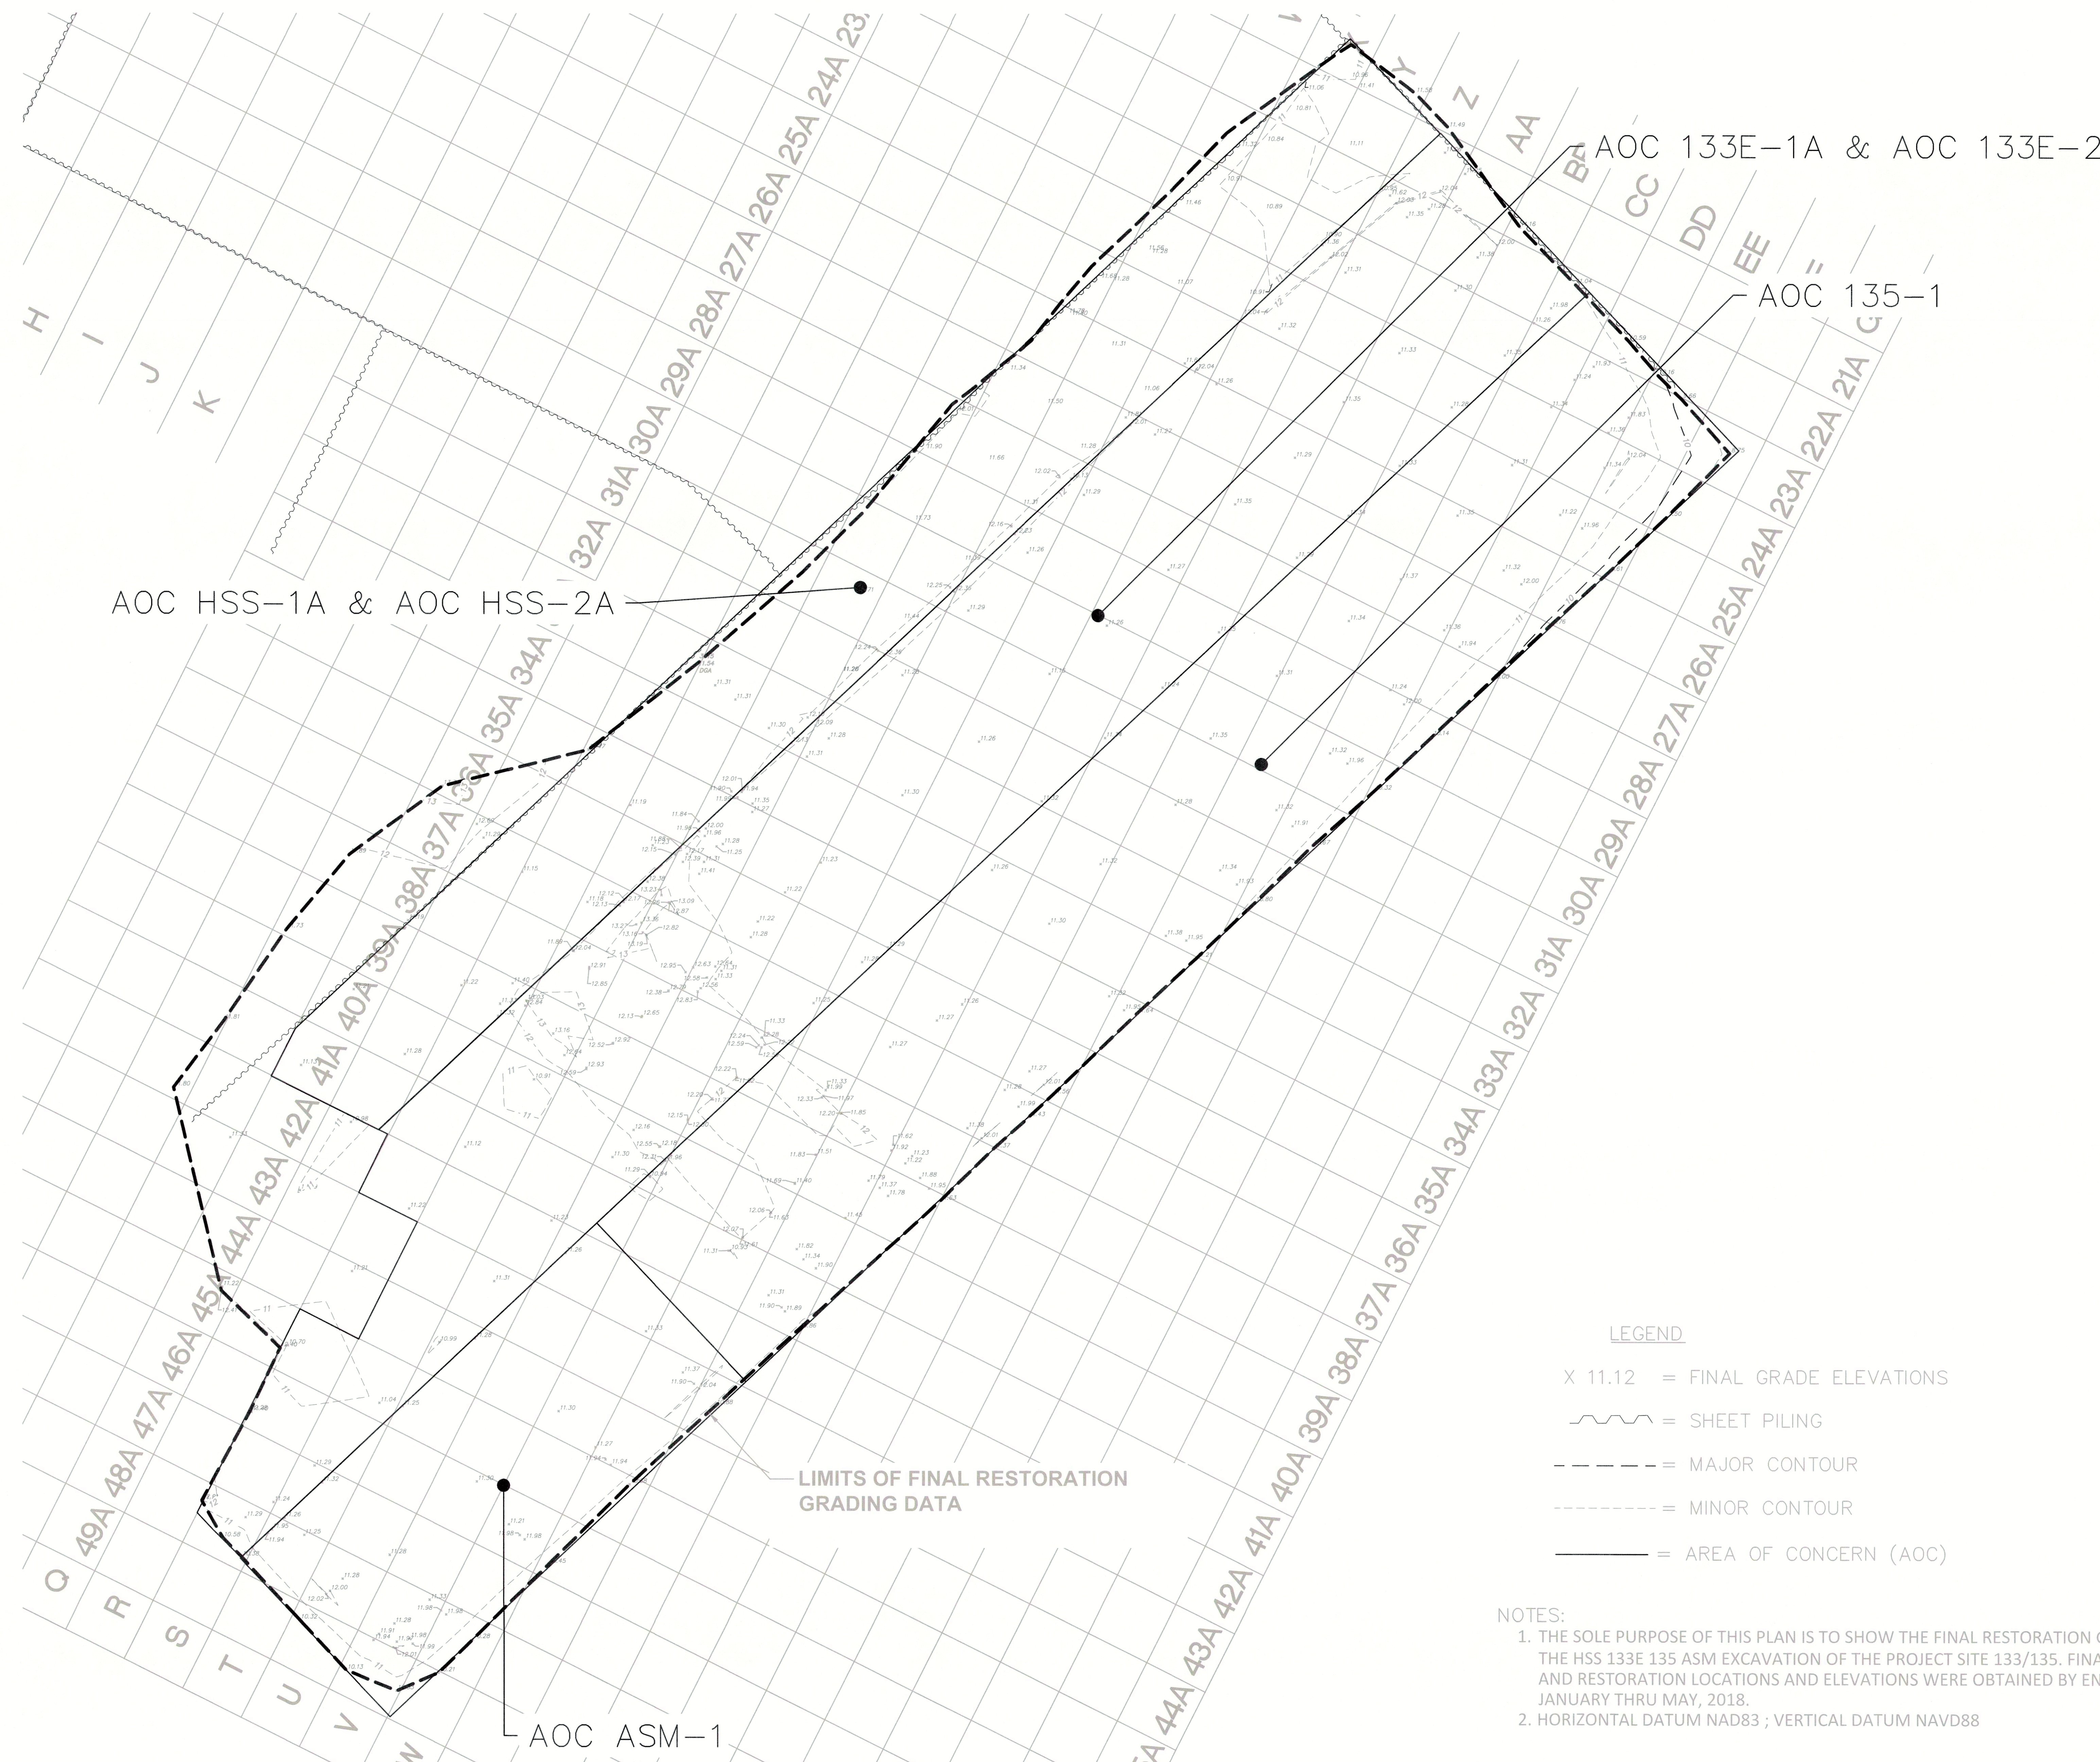

AOC 135-1

LEGEND

- X 11.12 = FINAL GRADE ELEVATIONS
 = SHEET PILING
 = MAJOR CONTOUR
 = MINOR CONTOUR
 = AREA OF CONCERN (AOC)