

## **Appendix F**


### **As-Built Diagrams**

On the Restricted Area As-Built Diagrams:

- Exhibits B-1A and B-1B (Restricted Area A) address AOC FSP-1B and AOC FSP-2B; and
- Exhibits B-1C and B-1D (Restricted Area B) address AOC FSP-2A for informational purposes only.





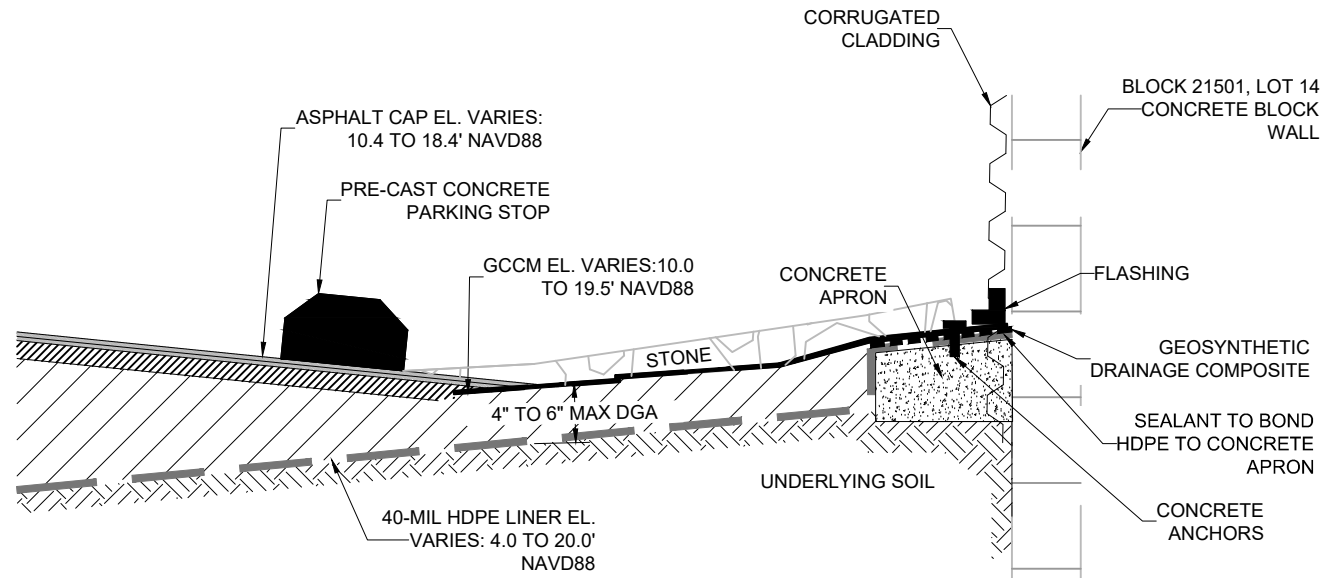

1 HDPE LINER OVERLAIN WITH DGA AND EITHER AN ASPHALT CAP OR GCCM NTS


# NOTES:

1. IN SOME LOCATIONS, STONE WAS PLACED ON TOP OF THE ASPHALT CAP AND GCCM FOR VISUAL IMPROVEMENTS. THE STONE DOES NOT SERVE AS AN ENGINEERING CONTROL.
2. ELEVATIONS LISTED REPRESENT RANGES ON BOTH BLOCK 21501, LOT 14 AND BLOCK 21501, LOT 15.


DGA DENSE-GRADED AGGREGATE  
 EL. ELEVATION  
 GCCM GEOSYNTHETIC CEMENTITIOUS COMPOSITE MAT  
 HDPE HIGH-DENSITY POLYETHYLENE  
 NAVD88 NORTH AMERICAN VERTICAL DATUM OF 1988  
 NTS NOT TO SCALE  
 PI PROGRAM INTEREST

**AECOM**

BLOCK 21501, LOT 15 PI NUMBER 775706 JERSEY CITY, HUDSON COUNTY, NEW JERSEY			ENGINEERING CONTROL AS-BUILT TYPICAL SECTION/RESTRICTED AREA A HDPE LINER OVERLAIN WITH DGA AND EITHER AN ASPHALT CAP OR GCCM	
DATE: 07/23/2019	DRWN: ASK, ALC		EXHIBIT B-1B	

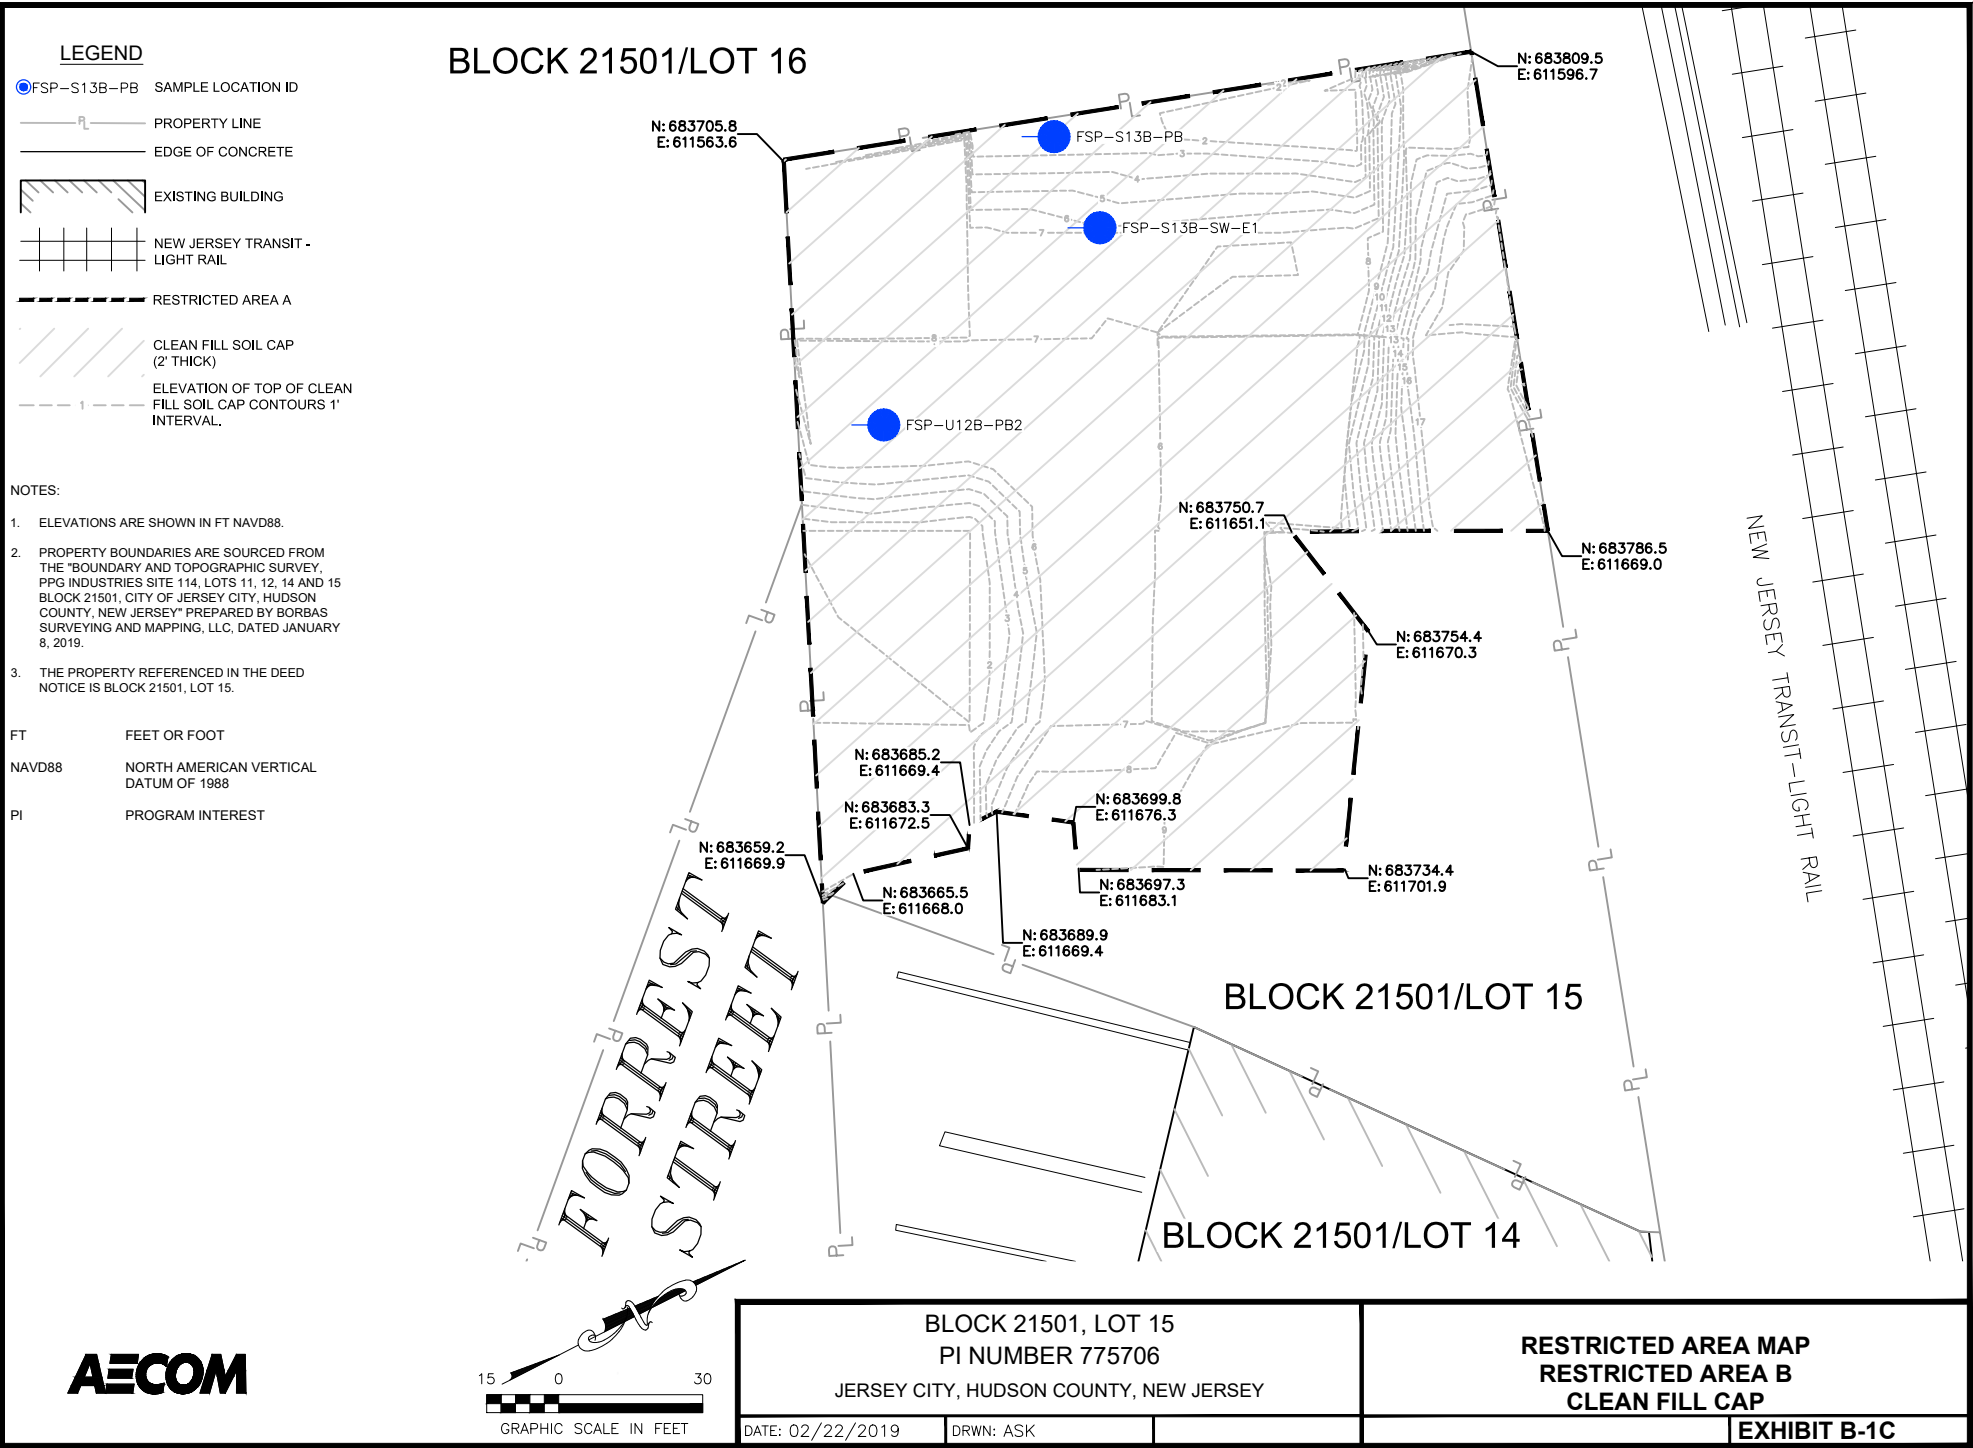



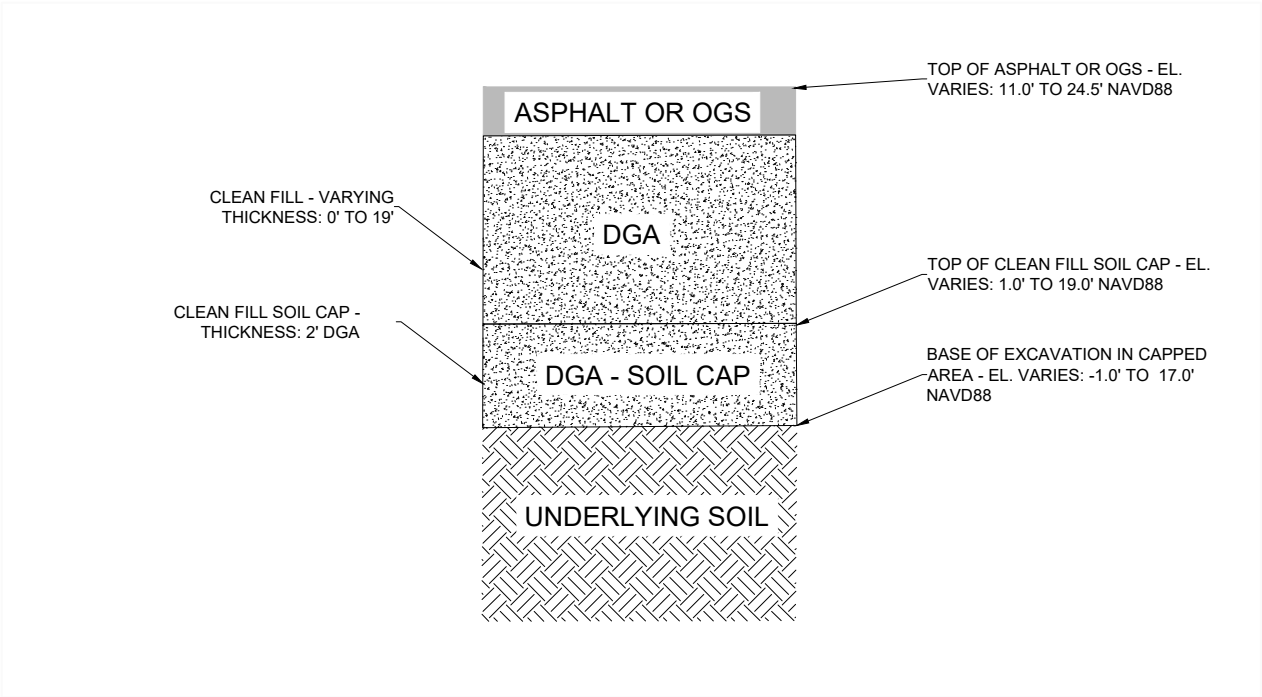


1 CLEAN FILL SOIL CAP  
NTS

NOTES:

- 1. DGA MAY BE AMENDED WITH FERROBLACK®-H, WHICH SERVES AS A PHASE OF GROUNDWATER REMEDIATION.
- 2. IN PORTIONS OF THE RESTRICTED AREA, RESTORATION CONSISTED OF BACKFILLING TO GRADE WITH DGA OVERLAIN WITH OGS. IN PORTIONS OF THE RESTRICTED AREA, RESTORATION CONSISTED OF BACKFILLING TO GRADE WITH DGA OVERLAIN WITH ASPHALT. THE OGS AND ASPHALT ARE NOT A COMPONENT OF THE ENGINEERING CONTROL.

DGA DENSE-GRADED AGGREGATE  
EL. ELEVATION  
NAVD88 NORTH AMERICAN VERTICAL DATUM OF 1988  
NTS NOT TO SCALE  
OGS OPEN-GRADE STONE  
PI PROGRAM INTEREST

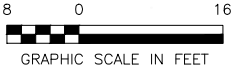

BLOCK 21501, LOT 15 PI NUMBER 775706 JERSEY CITY, HUDSON COUNTY, NEW JERSEY			ENGINEERING CONTROL AS-BUILT TYPICAL SECTION RESTRICTED AREA B CLEAN FILL CAP	
DATE: 02/22/2019	DRWN: ASK			EXHIBIT B-1D



LEGEND

x 0.00 = POST EXCAVATION ELEVATIONS

———— = AREA OF CONCERN (AOC)

—— ——— = PROPERTY LINE