
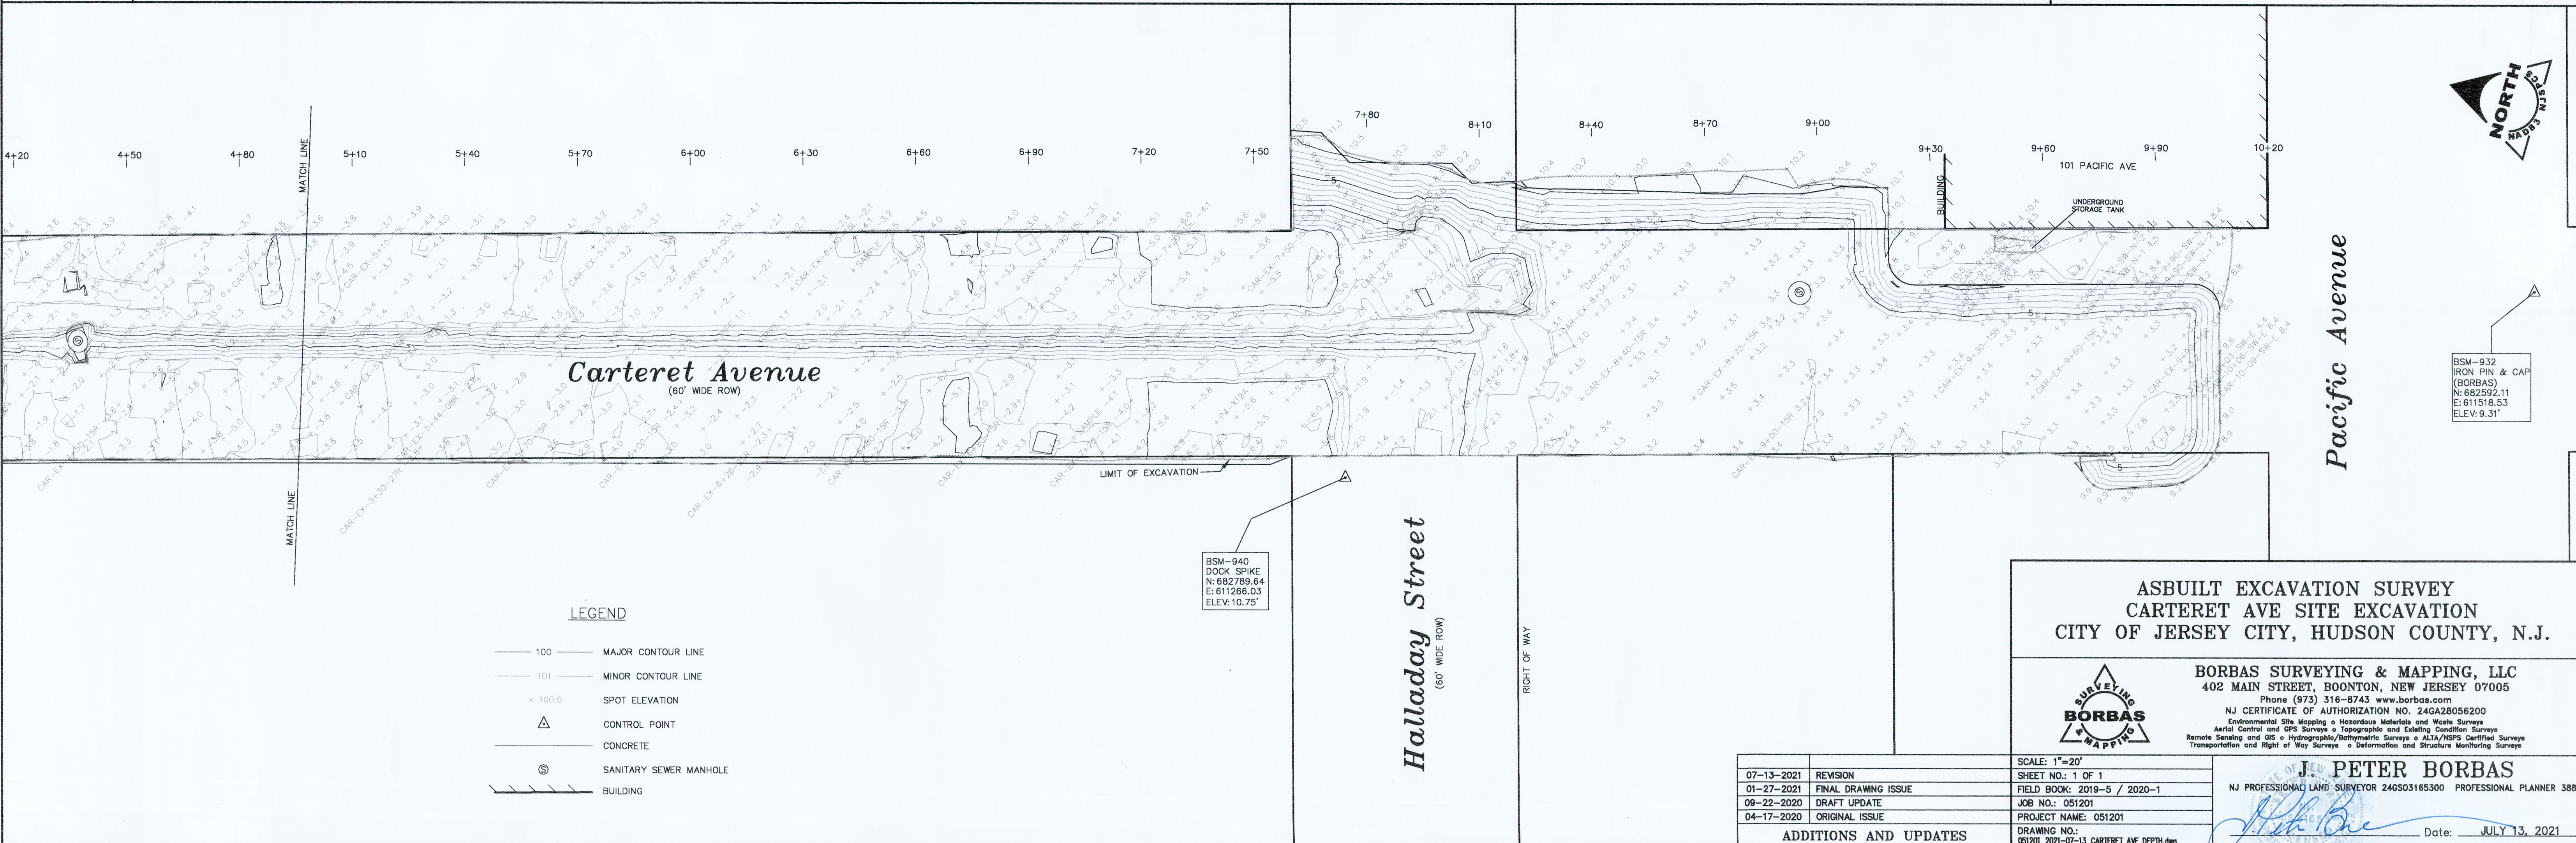


Appendix F

As-Built Diagrams

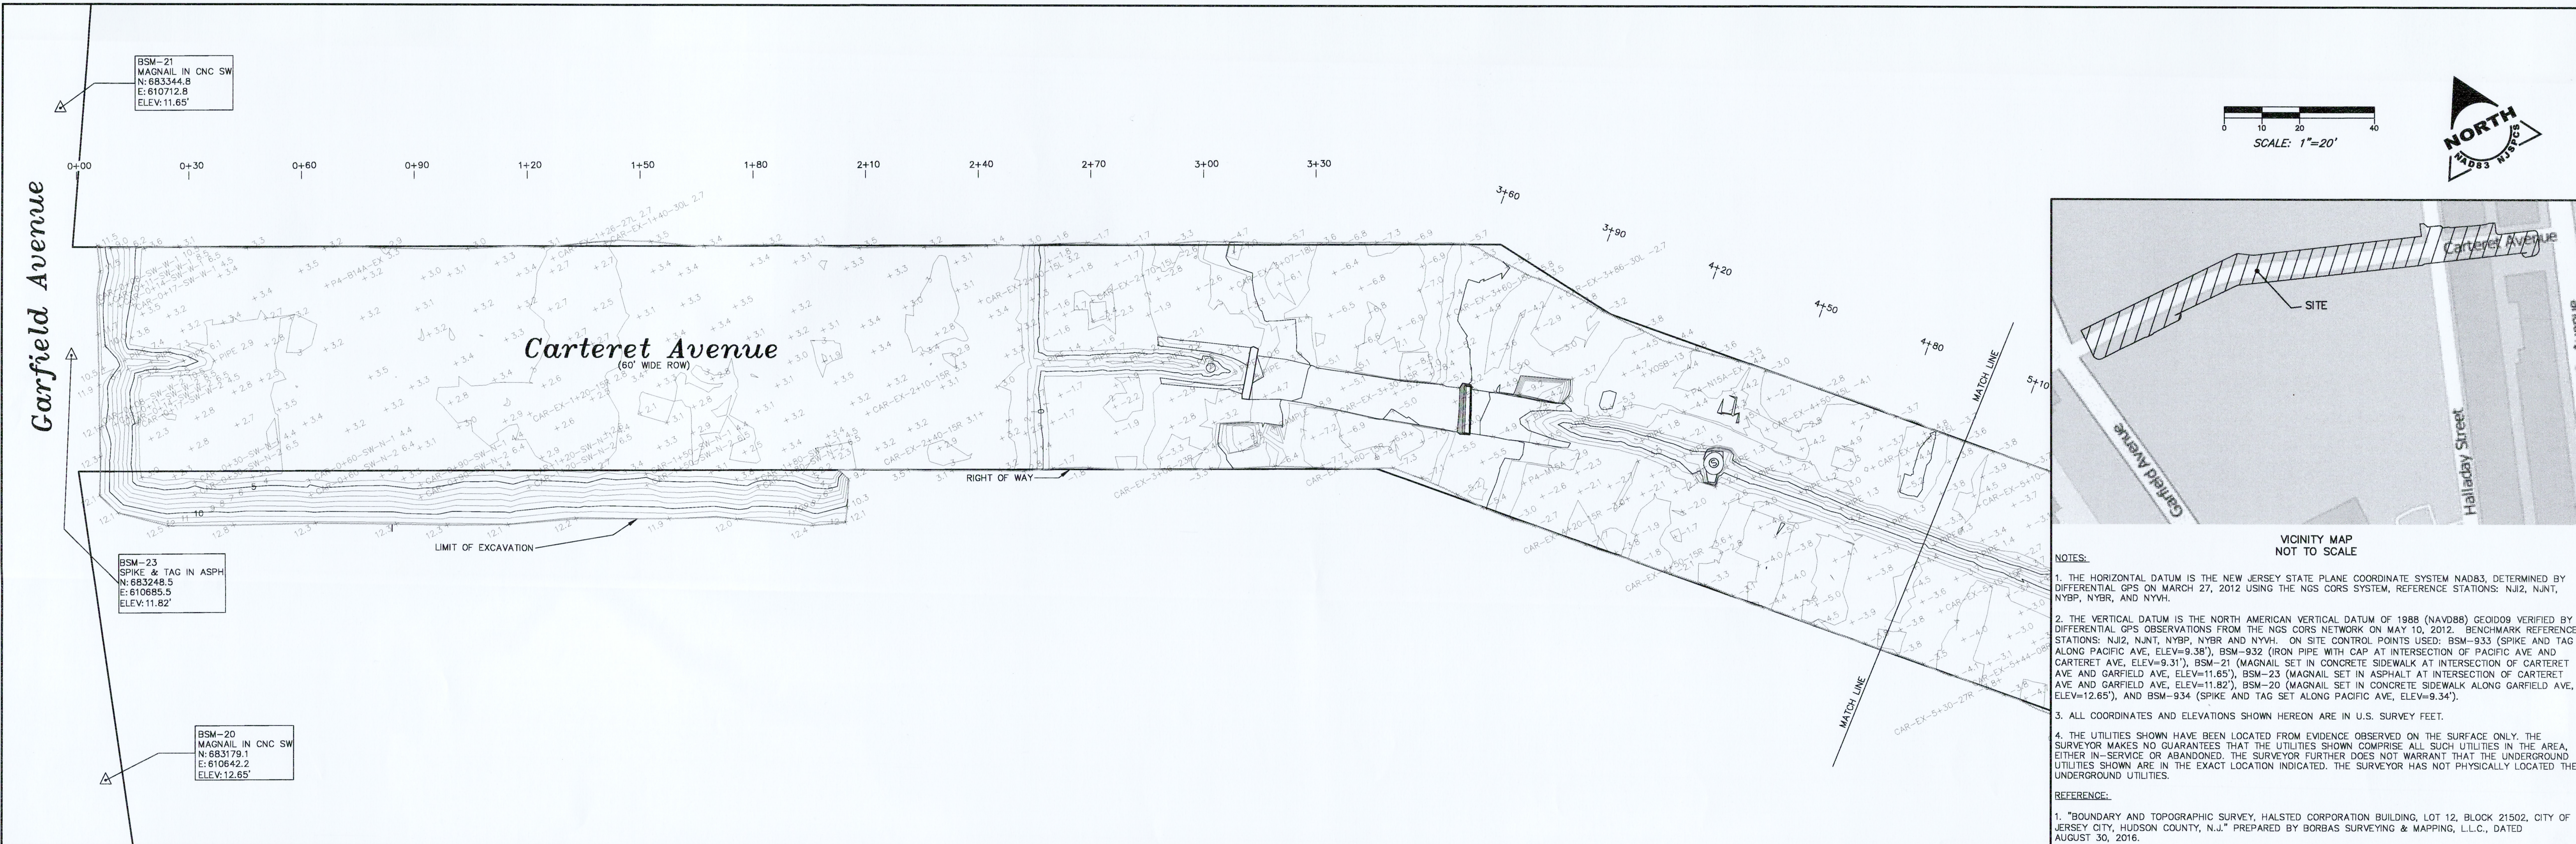

LEGEND

- 100 MAJOR CONTOUR LINE
- 101 MINOR CONTOUR LINE
- x 100.0 SPOT ELEVATION
- △ CONTROL POINT
- CONCRETE
- SANITARY SEWER MANHOLE
- /// BUILDING


ASBUILT EXCAVATION SURVEY
CARTERET AVE SITE EXCAVATION
CITY OF JERSEY CITY, HUDSON COUNTY, N.J.

BORBAS SURVEYING & MAPPING, LLC
402 MAIN STREET, BOONTON, NEW JERSEY 07005
Phone (973) 316-6743 www.borbas.com
NJ CERTIFICATE OF AUTHORIZATION NO. 246A28056200
Environmental Site Mapping • Hazardous Materials and Waste Surveys
Aerial Control and GPS Surveys • Topographic and Existing Condition Surveys
Remote Sensing and GIS • Hydrographic/Bathymetric Surveys • ALTA/NSPS Certified Surveys
Transportation and Right of Way Surveys • Deformation and Structure Monitoring Surveys


J. PETER BORBAS
NJ PROFESSIONAL LAND SURVEYOR 246S03165300 PROFESSIONAL PLANNER 3884
Date: JULY 13, 2021

07-13-2021	REVISION
01-27-2021	FINAL DRAWING ISSUE
09-22-2020	DRAFT UPDATE
04-17-2020	ORIGINAL ISSUE
ADDITIONS AND UPDATES	

SCALE: 1"=20'
SHEET NO.: 1 OF 1
FIELD BOOK: 2019-S / 2020-1
JOB NO.: 051201
PROJECT NAME: 051201
DRAWING NO.: 051201_2021-07-13_CARTERET_AVE_DEPTH.dwg

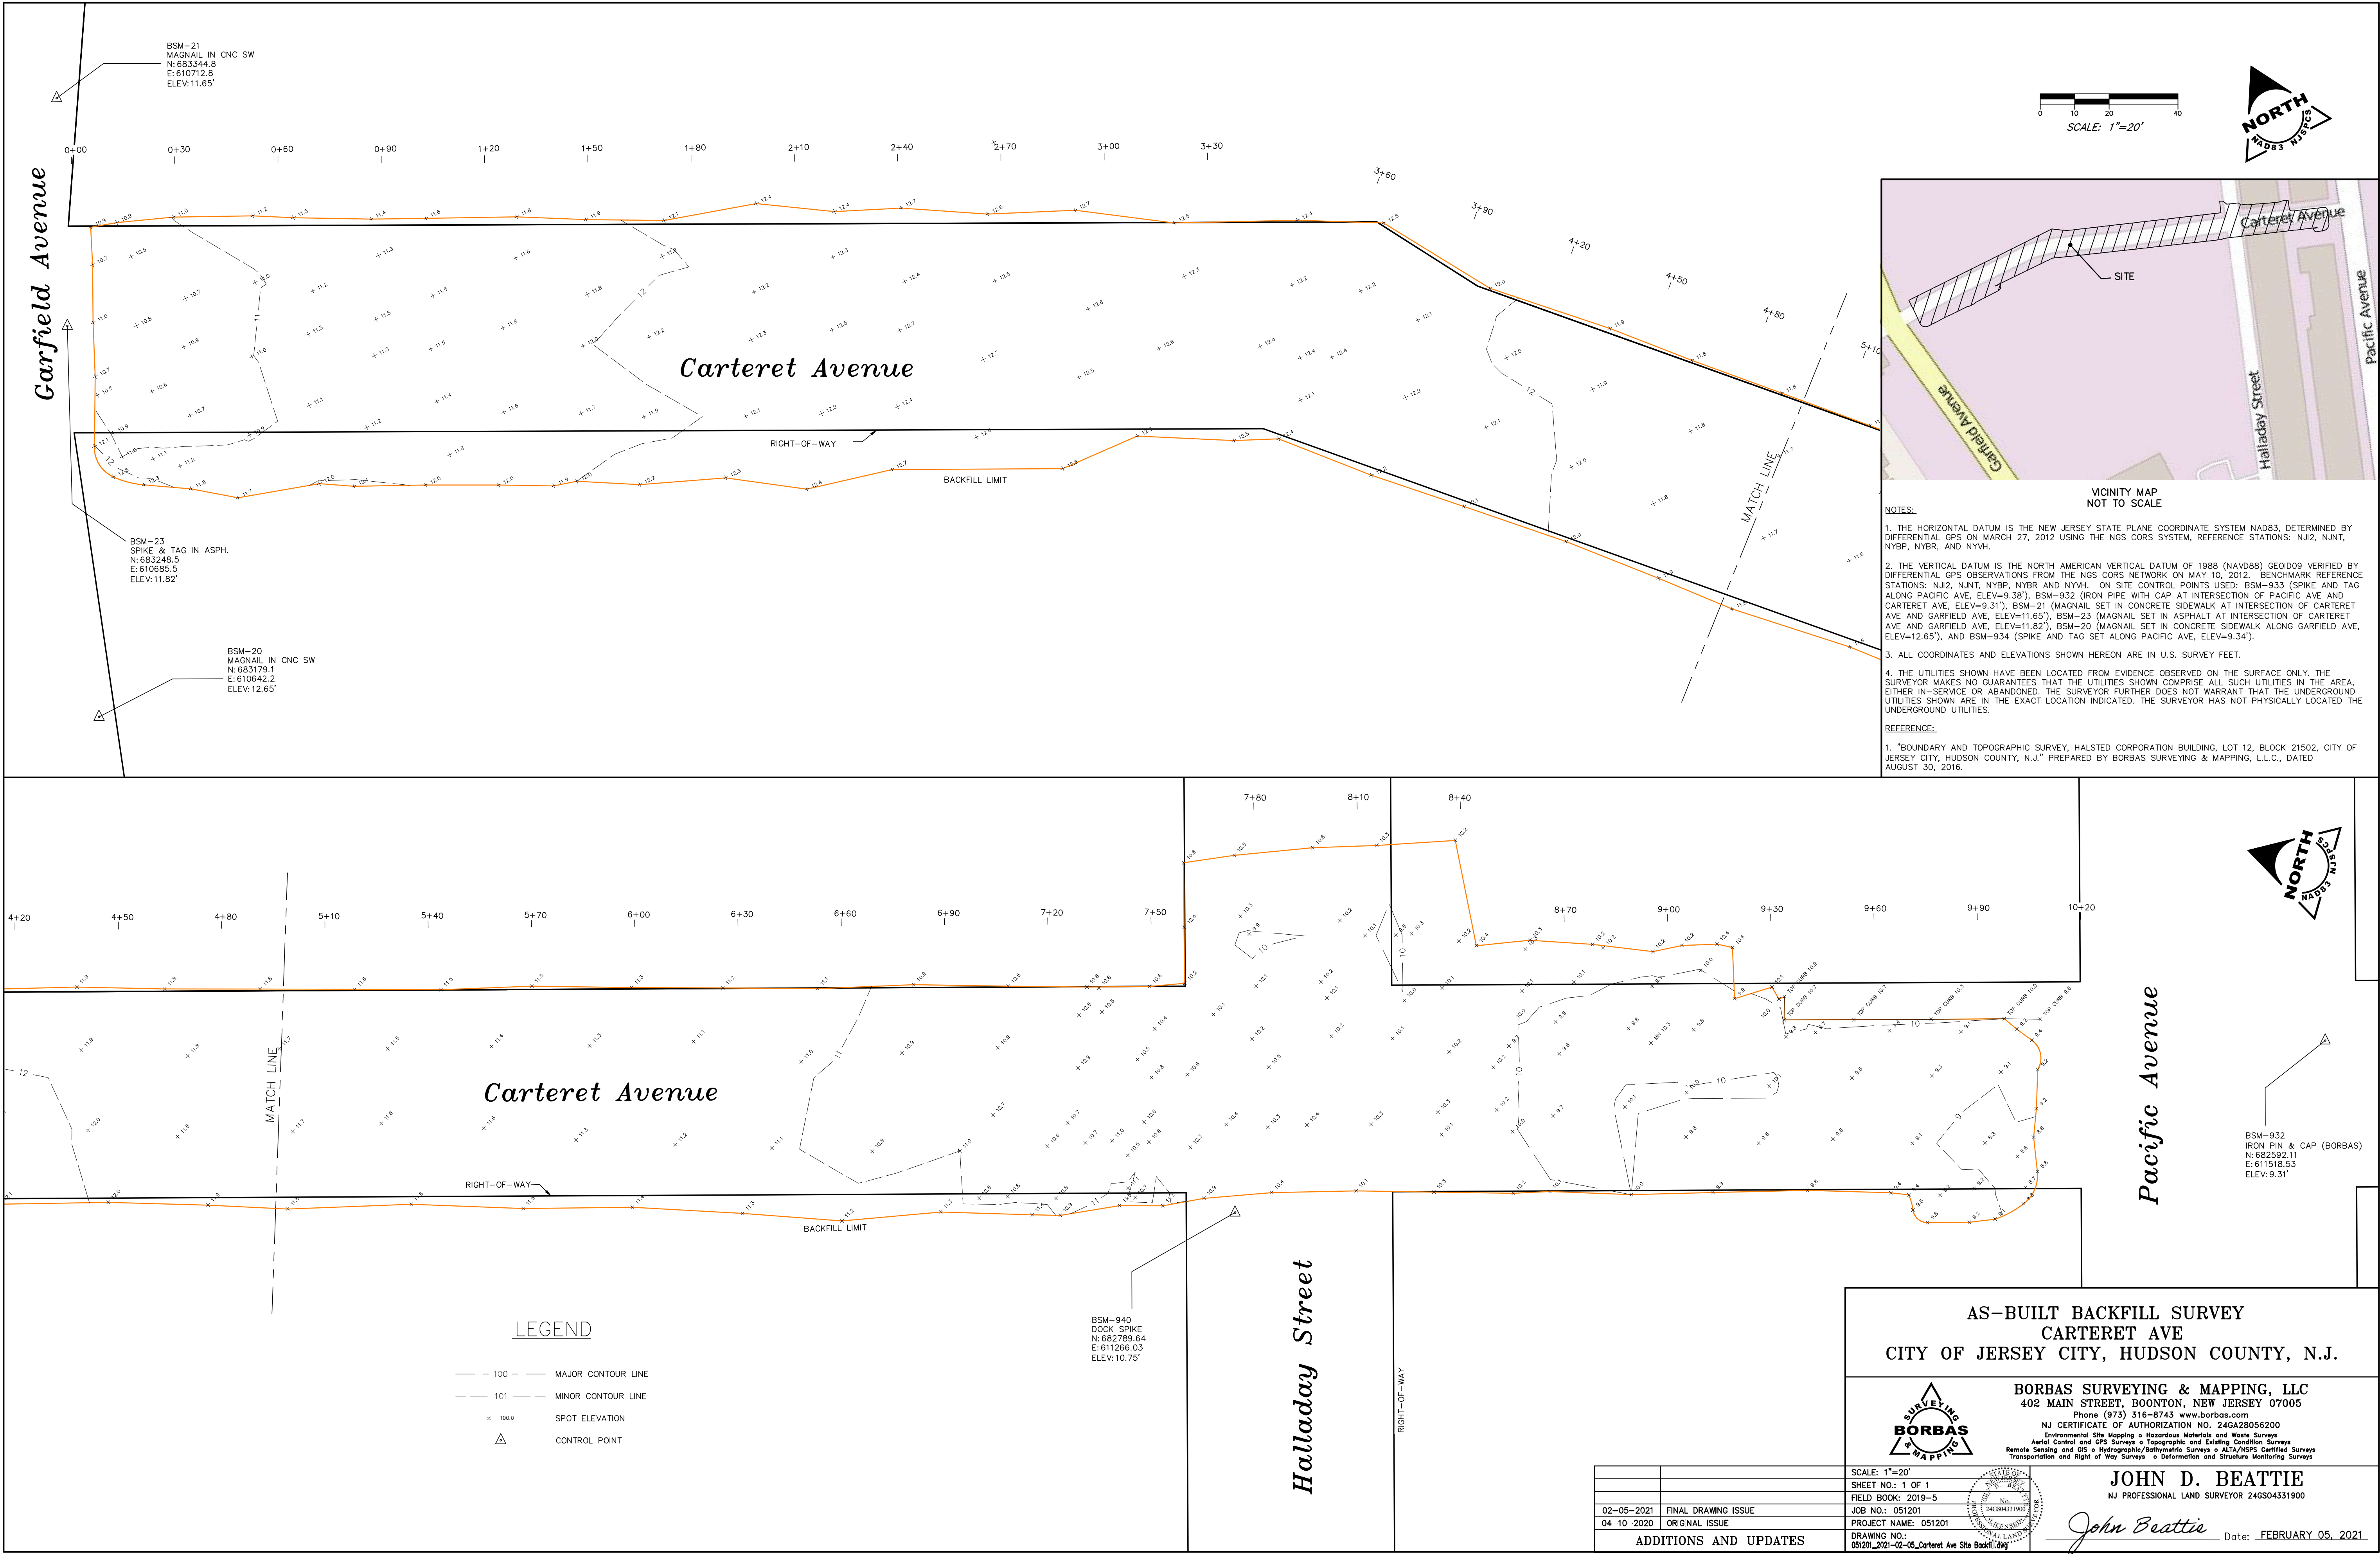


LEGEND

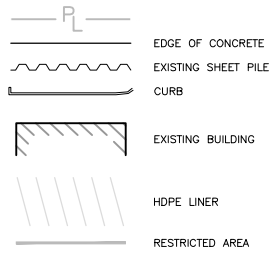


NOTES:

- COPR — CHROMITE ORE PROCESSING RESIDUE
- Cr+6 — HEXAVALENT CHROMIUM
- HDPE — HIGH-DENSITY POLYETHYLENE
- NAD 83 — NORTH AMERICAN DATUM OF 1983
- PI — PROGRAM INTEREST

1. PROPERTY BOUNDARIES ARE SOURCED FROM SURVEYS CONDUCTED FROM NOVEMBER 2006 TO JULY 2014 BY BORBAS SURVEYING AND MAPPING, LLC.

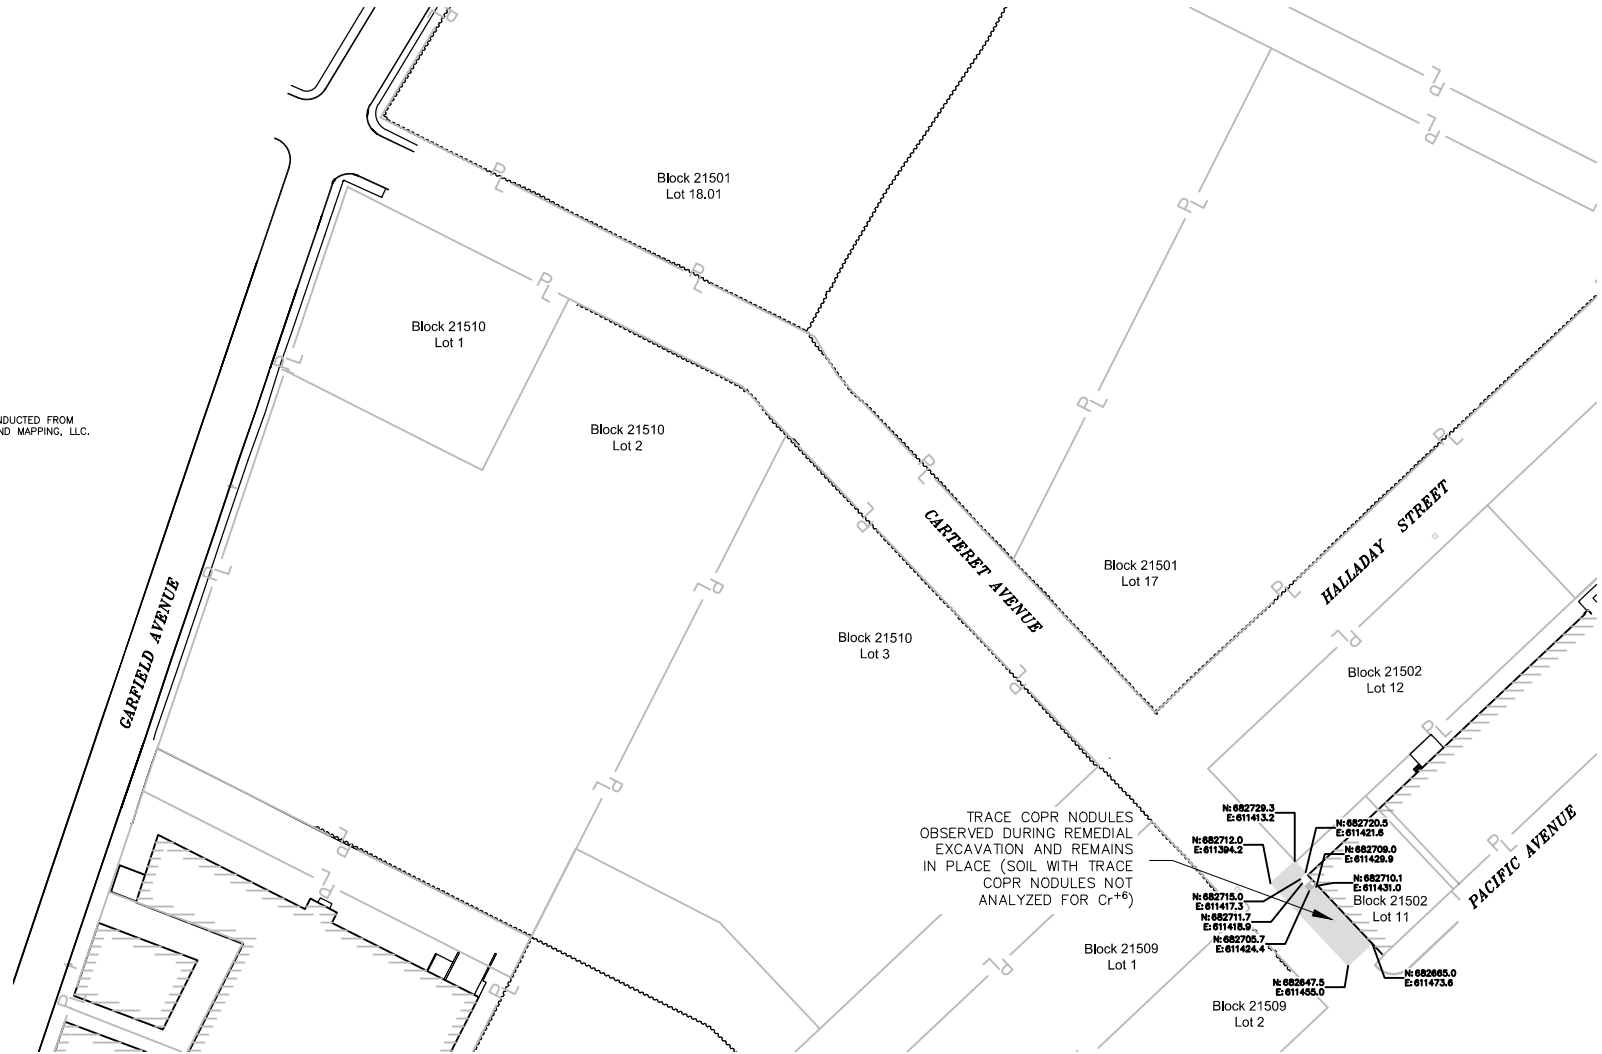

AECOM

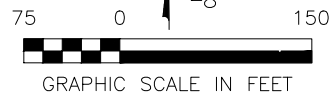

CARTERET AVENUE
PI NUMBER G000005480
JERSEY CITY, HUDSON COUNTY, NEW JERSEY

DATE: 03/19/2021

DRWN: SAP

AS-BUILT
HDPE LINER
ENGINEERING CONTROL

AS-BUILT